

STATE OF KANSAS
STATE CORPORATION COMMISSION

WELL PLUGGING RECORD


Give All Information Completely
Make Required Affidavit
Mail or Deliver Report to
Conservation Division
State Corporation Comm.
245 North Water
Wichita, KS 67202

Meade County, Sec. 30 Twp. 33S Rge. 27W E/W
Location as "NE/CNW $\frac{1}{4}$ SW $\frac{1}{4}$ " or footage from lines PPC SW SE
(660' FSL & 2090' FEL)

Lease Owner Mesa Petroleum Company
Lease Name Todd Well No. I-30

Office Address Box 2009, Amarillo, Texas
Character of Well (Completed as Oil, Gas or Dry Hole) Dry hole

Date Well completed 6-12 1978
Application for plugging filed 19
Application for plugging approved 6-13 1978
Plugging commenced 6-13 1978
Plugging completed 6-14 1978
Reason for abandonment of well or producing formation

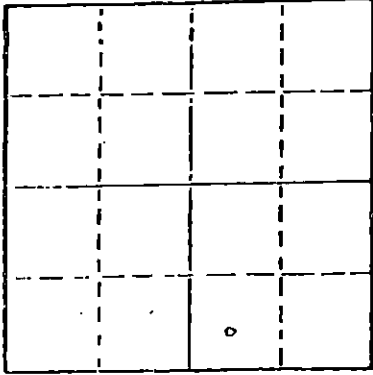

Locate well correctly on above
Section Plot

If a producing well is abandoned, date of last production 19

Was permission obtained from the Conservation Division or its agents before plugging was commenced? yes

Name of Conservation Agent who supervised plugging of this well Clarence Thomas
Producing formation Depth to top Bottom Total Depth of Well 6085'
Show depth and thickness of all water, oil and gas formations.

OIL, GAS OR WATER RECORDS

CASING RECORD

FORMATION	CONTENT	FROM	TO	SIZE	PUT IN	PULLED OUT
				9 5/8	1514	none

Describe in detail the manner in which the well was plugged, indicating where the mud fluid was placed and the method or methods used in introducing it into the hold. If cement or other plugs were used, state the character of same and depth placed, from feet to feet for each plug-set.
60 sacks @ 1500'
10 sacks 40-0'
5 sacks rat hole

RECEIVED
STATE CORPORATION COMMISSION
JUN 16 1978
CONSERVATION DIVISION
Wichita, Kansas

(If additional description is necessary, use BACK of this sheet)

Name of Plugging Contractor Halliburton @ Liberal, Kansas 67901


STATE OF Kansas COUNTY OF Seward, ss.
Harold K. Frauli, Agent (employee of owner) or (owner or operator)
of the above-described well, being first duly sworn on oath, says: That I have knowledge of the facts, statements, and matters herein contained and the log of the above-described well as filed and that the same are true and correct. So help me God.

(Signature) Harold K. Frauli
P.O. Box 1578, Liberal, Kansas 67901
(Address)

SUBSCRIBED AND SWORN TO before me this 15th day of June, 19 78

Janice Heckman
Notary Public.

My commission expires 9-1-78

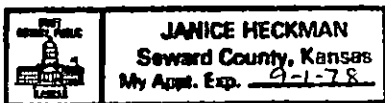

Recvd. Ama. Prod.

DRILLING LOG

JUL 10 1978

Todd #1-30

JLF	1
SD	

GD	<input checked="" type="checkbox"/>
TL5	

CASING RECORD:	OPERATOR:	Mesa Petroleum	DESCRIPTION:
9-5/8" set @ 1514'	CONTRACTOR:	Ford Tool Co.	660' from S & 2090'
w/600 sacks cement	COMMENCED:	May 20, 1978	from East
			Sec. 30-33S-27W
			Meade County, Kansas
TOTAL DEPTH:	COMPLETED:	June 14, 1978	
6085'			

<u>FORMATION</u>	<u>FROM</u>	<u>TO</u>	<u>REMARKS</u>
Sand	0	1810	
Anhydrite & shale	1810	2475	
Lime & shale	2475	2955	
Dolomite & shale	2955	3550	
Lime & shale	3550	5782	
Lime	5782	6085	RTD Plugged well w/85 sacks cement

I certify that this is a true and correct copy of the log on the above captioned well to the best of my knowledge.

FORD TOOL CO.

By *Lee Johnson*

Subscribed and sworn to before me this 7th day of July, 1978.

Carol Giles
Notary Public

My Commission Expires: 9-30-78

RECEIVED
STATE CORPORATION COMMISSION

SEP 28 1978

CONSERVATION DIVISION
Wichita, Kansas