


15-189-00015-0000

STATE OF KANSAS
STATE CORPORATION COMMISSION

WELL PLUGGING RECORD

Give All Information Completely
Make Required Affidavit
Mail or Deliver Report to:
Conservation Division
State Corporation Commission
800 Bitting Building
Wichita, Kansas

Stevens County, Sec. 36 Twp. 31S Rge. 7E 36(W)
Location as "NE/CNW/SW" or footage from lines C SE NW
Lease Owner Shell Oil Company
Lease Name Carlisle Well No. 1-36
Office Address Post Office Box 744, Great Bend, Kansas
Character of Well (completed as Oil, Gas or Dry Hole) Dry Hole
Date well completed July 20 1959
Application for plugging filed July 29 1959
Application for plugging approved (Verbal) July 20 1959
Plugging commenced July 20 1959
Plugging completed July 21 1959
Reason for abandonment of well or producing formation

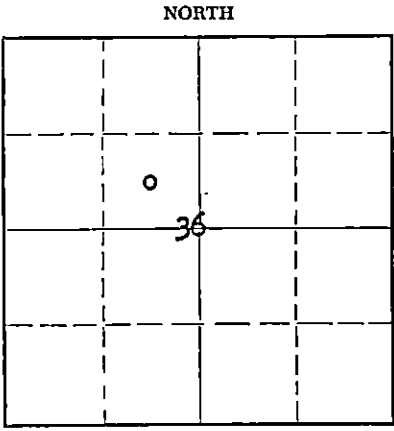

Locate well correctly on above Section Plat

If a producing well is abandoned, date of last production 19
Was permission obtained from the Conservation Division or its agents before plugging was commenced? Yes

Name of Conservation Agent who supervised plugging of this well Merle A. Rives
Producing formation Mississippian Depth to top 6320 Bottom - Total Depth of Well 6640 Feet
Show depth and thickness of all water, oil and gas formations.

OIL, GAS OR WATER RECORDS

CASING RECORD

FORMATION	CONTENT	FROM	TO	SIZE	PUT IN	PULLED OUT
Mississippian	* 304 MCFG PD & 3 BSWPH	6356	6370	8-5/8"	729'	None
				4-1/2"	6477'	538'
Norrowan	* 176 MCFG PD; 338 bbl frac water not recovered.	6281	6287			
* Non-commercial.						

Describe in detail the manner in which the well was plugged, indicating where the mud fluid was placed and the method or methods used in introducing it into the hole. If cement or other plugs were used, state the character of same and depth placed, from feet to feet for each plug set.

Completion data: 7" csg cem 6477. Drilled Howco DV tool, cement 6402-6408, Howco baffle & cement 6409-6437 PBD.

Killed well with fresh water by Halliburton. Circulated with tubing at 6293. Checked rathole fillup. Lowered tubing to 6308 - top of sand in hole after fracture treatment. Pumped 20 sax cement through tubing, leaving plug 6308-6020. Displaced fresh water with heavy rotary mud. Pumped 7 sax cement through tubing, leaving plug 800-705. Filled 8-5/8" surface casing with heavy rotary mud to 40', set rock bridge to 38' & filled to 6' from surface with 10 sax cement.

STATE CORPORATION COMMISSION
JUL 31 1959
CONSERVATION DIVISION
Wichita, Kansas

(If additional description is necessary, use BACK of this sheet)
Name of Plugging Contractor Gibbins & Slentz (w/ Halliburton)
Address Duncan, Oklahoma

STATE OF Kansas COUNTY OF Barton, ss.
A. W. Weber (employee of owner) of the above-described well, being first duly sworn on oath, says: That I have knowledge of the facts, statements, and matters herein contained and the log of the above-described well as filed and that the same are true and correct. So help me God.

(Signature) A. W. Weber
P. O. Box 744, Great Bend, Kansas (Address)

SUBSCRIBED AND SWORN TO before me this 29th day of July 19 59

My commission expires January 28, 1961
Notary Public.

24-7388-S 3-53-20M

PLUGGING
FILE SEC. 36 T. 34 R. 36W
BOOK PAGE 56 LINE 26

SHELL-CARLISLE #1-36
WILDCAT, HUGOTON FIELD (AREA 20)
C. SE NW Section 36-34S-36W

Casing Record

- 0 - 650 surface clay
- 741 red beds
- 943 shale
- 1503 red bed (salty)
- 1765 shale, sand & lime
- 1771 shale & sand
- 2381 shale & anhydrite
- 2470 lime & shale
- 2594 shale & lime
- 2795 lime & shale
- 2942 sandy lime & shale
- 3053 lime & shale
- 3085 lime & sand
- 3195 lime
- 3308 sand, lime & shale
- 3405 lime
- 3527 lime & shale w/ chert
- 3566 lime & sand
- 3623 lime
- 3759 lime, sand & shale
- 3901 lime
- 3983 lime & shale
- 4113 lime
- 4162 lime, shale & sand
- 4213 lime & shale
- 4290 shale w/ lime streaks
- 4377 lime
- 4440 lime & shale
- 4690 lime
- 4762 shale & lime
- 4922 lime & shale
- 5002 lime
- 5157 lime & shale
- 5451 lime
- 5615 lime & shale
- 5750 shale w/ lime streaks
- 5800 shale & lime
- 5903 lime
- 5944 lime & shale w/ sandstone

- 8 5/8" cem 729 with 700 sax
- 4 1/2" cem 6477 with 820 sax; perforated 6356-6370 & 6281-6287; recovered 538'
- 5985 shale
- 6113 shale & lime
- 6284 lime & shale
- 6310 sand & lime
- 6347 lime & shale
- 6354 lime, shale & sand
- 6422 shale & lime
- 6485 shale & sand
- 6578 sand, shale & lime
- 6592 shale, lime & sand
- 6640 lime, hard, sandy T.D.

STATE OF KANSAS)
) SS
COUNTY OF BARTON)

FILED
STATE OF KANSAS
JUL 31 1959
CONSERVATION DIVISION
Wichita, Kansas

I hereby affirm that the above and foregoing is a true and correct copy of the log of the Shell-Carlisle Area 20 No. 1-36 well, located in Section 36-34S-36W, Stevens County, Kansas.

PLUGGING
FILE SEC. 36 T. 34 R. 36W
BOOK PAGE 56 LINE 26

SHELL OIL COMPANY
by J. W. Weber
District Superintendent

Subscribed and sworn to before me a Notary Public this 29th day of July, 1959.

My commission expires January 28, 1961 L. Mont Byers Jr. Notary Public