

STATE OF KANSAS  
STATE CORPORATION COMMISSION

Form CP-4

WELL PLUGGING RECORD

Give All Information Completely  
Make Required Affidavit  
Mail or Deliver Report to:  
Conservation Division  
State Corporation Commission  
212 No. Market  
Wichita, Kansas

Stevens

County, Sec. 26 Twp. 34S Rge. 36W (E) (W)

Location as "NE/CNW/SW" or footage from lines 1981' FEL and 660' FSL

Lease Owner Mobil Oil Corporation

Lease Name Sarah Norton Well No. 1

Office Address P. O. Box 5444, Denver, CO 80217-5444

Character of Well (completed as Oil, Gas or Dry Hole) Dry Hole

Date well completed 7/31/82 19

Application for plugging filed verbal approval 7/31/82 19

Application for plugging approved verbal approval 7/31/82 19


Plugging commenced 12:15 p.m. 7/31/82 19

Plugging completed 6:40 p.m. 7/31/82 19

Reason for abandonment of well or producing formation Dry Hole

If a producing well is abandoned, date of last production 19

Was permission obtained from the Conservation Division or its agents before plugging was commenced? Verbal approval obtained 7/31/82

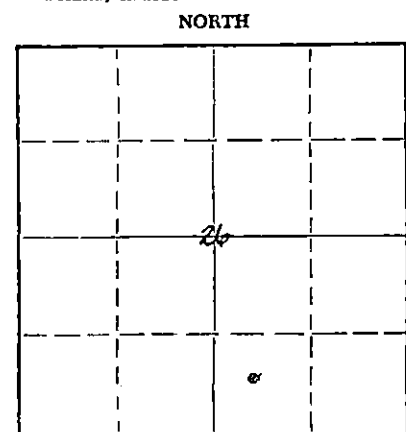

Locate well correctly on above Section Plat

Name of Conservation Agent who supervised plugging of this well None

Producing formation \_\_\_\_\_ Depth to top \_\_\_\_\_ Bottom \_\_\_\_\_ Total Depth of Well 6810 Feet

Show depth and thickness of all water, oil and gas formations.

OIL, GAS OR WATER RECORDS

CASING RECORD

FORMATION	CONTENT	FROM	TO	SIZE	PUT IN	PULLED OUT
Surface casing	12% gel+3% CaCl <sub>2</sub>	0	1770'	9-5/8"	350 sx	- 1st stage
	3% CaCl <sub>2</sub>	0	1770'	9-5/8"	100 sx	- 2nd stage

Describe in detail the manner in which the well was plugged, indicating where the mud fluid was placed and the method or methods used in introducing it into the hole. If cement or other plugs were used, state the character of same and depth placed, from \_\_\_\_\_ feet to \_\_\_\_\_ feet for each plug set.

- 10 sx Class H cement plug set 0' to 40'
- 25 sx Class H cement plug set 818' to 880'
- 35 sx Class H cement plug set 1732' to 1820'
- 50 sx Class H cement plug set 5074' to 5200'
- 50 sx Class H cement plug set 6174' to 6300'

Put metal cap over hole:

(If additional description is necessary, use BACK of this sheet)

Name of Plugging Contractor Halliburton Services

Address Box 1598, Liberal, KS 67901

STATE OF Colorado, COUNTY OF Denver, ss. C. J. Park

(employee of owner) or (owner or operator) of the above-described well, being first duly sworn on oath, says: That I have knowledge of the facts, statements, and matters herein contained and the log of the above-described well as filed and that the same are true and correct. So help me God.

(Signature) *C. J. Park*

P. O. Box 5444 Denver, CO 80217

(Address)

SUBSCRIBED AND SWORN to before me this 31 day of January, 1983

My commission expires 11-28-84

*Judith A. Olsen*  
Notary Public.

2-4-83  
FEB 4 1983