


STATE OF KANSAS  
STATE CORPORATION COMMISSION

Form CP-4

Give All Information Completely  
Make Required Affidavit  
Mail or Deliver Report to:  
Conservation Division  
State Corporation Commission  
P. O. Box 17027  
Wichita, Kansas 67217  
NORTH

WELL PLUGGING RECORD

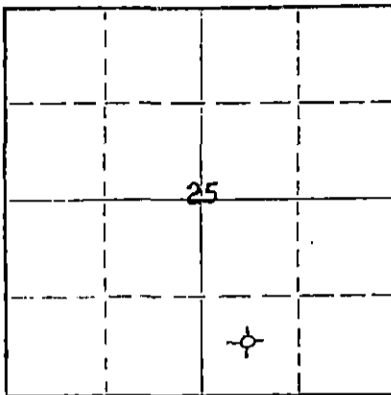

Locate well correctly on above  
Section Plat

Stevens County, Sec. 25 Twp. 34S Rge. (E) 36 (W)  
Location as "NE/CNWxSWx" or footage from lines C SW 1/4 SE 1/4  
Lease Owner Graham-Michaelis Corporation  
Lease Name Stalcup Well No. 1-25  
Office Address P. O. Box 247, Wichita, Kansas 67201  
Character of Well (completed as Oil, Gas or Dry Hole) Dry Hole  
Date well completed August 31, 19 73  
Application for plugging filed Sept. 4, 19 73  
Application for plugging approved (verbal) August 31, 19 73  
Plugging commenced August 31, 19 73  
Plugging completed August 31, 19 73  
Reason for abandonment of well or producing formation Non Commercial

If a producing well is abandoned, date of last production None 19  
Was permission obtained from the Conservation Division or its agents before plugging was com-  
menced? Yes, verbal.

Name of Conservation Agent who supervised plugging of this well Leo Massey, Hays, Kansas  
Producing formation None Depth to top Bottom Total Depth of Well 6560 Feet  
Show depth and thickness of all water, oil and gas formations.

OIL, GAS OR WATER RECORDS

CASING RECORD

FORMATION	CONTENT	FROM	TO	SIZE	PUT IN	PULLED OUT
				8 5/8"	1731'	None

Describe in detail the manner in which the well was plugged, indicating where the mud fluid was placed and the method or methods used in introducing it into the hole. If cement or other plugs were used, state the character of same and depth placed, from feet to feet for each plug set.

Filled hole with heavy mud to 2850', dumped 100 sacks cement for plug from 2850-2650'; filled with heavy mud to 1700', 35 sack cement plug at 1700'; filled with heavy drilling mud to 400'; 25 sack cement plug at 400'; filled with heavy drilling mud to 50'; 10 sack cement plug from 50' to surface. 5 sacks cement in rat hole; 5 sacks cement in mouse hole.

RECEIVED  
STATE CORPORATION COMMISSION  
SEP 7 1973  
CONSERVATION DIVISION  
Wichita, Kansas

(If additional description is necessary, use BACK of this sheet)  
Name of Plugging Contractor Rains & Williamson Oil Company, Inc.  
Address 435 Page Court, Wichita, Kansas 67202

STATE OF Kansas, COUNTY OF Sedgwick, ss.  
Jack L. Yinger (employee of owner) or (owner or operator) of the above-described well, being first duly sworn on oath, says: That I have knowledge of the facts, statements, and matters herein contained and the log of the above-described well as filed and that the same are true and correct. So help me God.

(Signature) Jack L. Yinger  
P. O. Box 247, Wichita, Kansas 67201  
(Address)

SUBSCRIBED AND SWORN TO before me this 4th day of September, 19 73

Muriel F. C. Jeram  
Notary Public.

My commission expires  
MURIEL F. C. JERAM  
NOTARY PUBLIC  
SEDGWICK COUNTY, KANSAS  
MY COMMISSION EXPIRES  
JULY 25, 1976

# WELL LOG

COMPANY Graham-Michaelis Corporation

SEC. 25 T. 34S R. 36W

FARM Stalcup NO. 1-25

LOC. SW SE

RIG. NO. 5


COUNTY Stevens

TOTAL DEPTH 6560

KANSAS

COMM. 8-15-73

COMP. 8-31-73

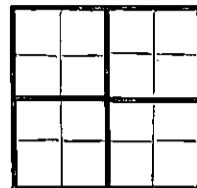

CONTRACTOR Rains & Williamson Oil Co., Inc.

**CASING**

20	10
15	8 5/8" @ 1731' w/ 1600 sx. alcolite, 2% cc,
12	6 & 200 sx. common, 3% cc.
13	5

ELEVATION

PRODUCTION D & A

FIGURES INDICATE BOTTOM OF FORMATIONS

Sand	440
Sand and Red Bed and Gyp Sand	1128
Sand and Red Bed	1715
Red Bed and Gyp	1907
Red Bed	2410
Red Bed and Anhydrite	2464
Shale and Lime	2730
Lime and Shale	2895
Shale and Lime	3037
Lime and Shale	3205
Shale and Lime	3508
Lime and Shale	3978
Lime	4585
Lime and Shale	4770
Lime	5284
Lime and Shale	5502
Lime	5903
Lime and Shale	6024
Shale	6288
Shale and Lime	6390
Lime and Shale	6472
Lime	6560
<u>Rotary Total Depth</u>	<u>6560</u>

RECEIVED  
STATE CORPORATION COMMISSION  
SEP 7 1973  
CONSERVATION DIVISION  
Wichita, Kansas

State of Kansas }  
County of Sedgwick } ss:

I, Wilson Rains, President of the Rains & Williamson Oil Co., Inc. ~~XXXXXX~~

upon oath state that the above and foregoing is a true and correct copy of the log of the Stalcup #1-25 well.

Wilson Rains  
WILSON RAINS



Subscribed and sworn to before me this 4th day of September 19 73

Juanita M. Green  
NOTARY PUBLIC  
Juanita M. Green

My Commission Expires: October 4, 1975