


STATE OF KANSAS
STATE CORPORATION COMMISSION

Form CP-4

Give All Information Completely
Make Required Affidavit
Mail or Deliver Report to:
Conservation Division
State Corporation Commission
P. O. Box 17027
Wichita, Kansas 67217
NORTH

WELL PLUGGING RECORD

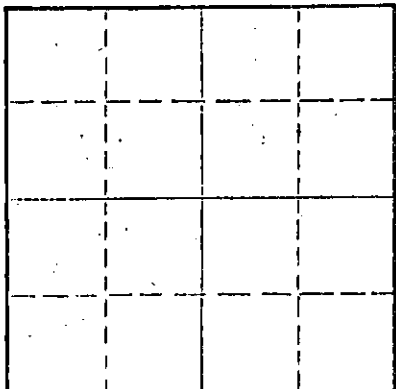

Stevens County, Sec. 19 Twp. 34S Rge. (E) 36 (W)
Location as "NE/CNWSW" or footage from lines C NW
Lease Owner Campbell & Marden
Lease Name Peachy Well No. 1-19
Office Address Box 1313, Liberal, Kansas 67901
Character of Well (completed as Oil, Gas or Dry Hole) Dry Hole
Date well completed March 30, 1973
Application for plugging filed 19
Application for plugging approved 19
Plugging commenced March 30, 1973
Plugging completed March 30, 1973
Reason for abandonment of well or producing formation Dry Hole

If a producing well is abandoned, date of last production 19
Was permission obtained from the Conservation Division or its agents before plugging was commenced? Yes (Edgar J. Eves of Sublette)

Name of Conservation Agent who supervised plugging of this well
Producing formation Depth to top Bottom Total Depth of Well 6875 Feet
Show depth and thickness of all water, oil and gas formations.

OIL, GAS OR WATER RECORDS

CASING RECORD

FORMATION	CONTENT	FROM	TO	SIZE	PUT IN	PULLED OUT
	Surface	0	1764'	8-5/8"	1764'	None
	Casing					

Describe in detail the manner in which the well was plugged, indicating where the mud fluid was placed and the method or methods used in introducing it into the hole. If cement or other plugs were used, state the character of same and depth placed, from feet to feet for each plug set.


Heavy Mud from Total Depth to 1100 Feet,
35 sax Cement Plug from 1100' to 1000';
Mud to 45 Feet, Plug Bridged & 35 sax
Cement to Base of Cellar; 2 sax Cement
in Rat Hole. Job Completed @ 8:00 A.M.

RECEIVED
STATE CORPORATION COMMISSION
APR 4 1973
CONSERVATION DIVISION
Wichita, Kansas

(If additional description is necessary, use BACK of this sheet)
Name of Plugging Contractor Halliburton
Address Box 129, Liberal, Kansas 67901

STATE OF KANSAS, COUNTY OF SEDGWICK, ss.
Clarence Michael of Sage Drilling Co. being first duly sworn on oath, says: That I have knowledge of the facts, statements, and matters herein contained and the log of the above-described well as filed and that the same are true and correct. So help me God.

(Signature) Clarence Michael
500 Bitting Bldg., Wichita, Kansas
(Address)

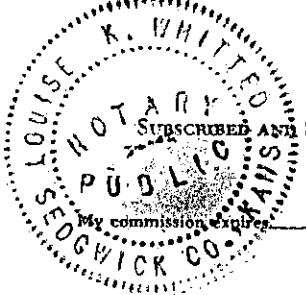

Sworn to before me this 2nd day of April, 1973
November 26, 1974.
Louise K. Whitted - Notary Public.

DRILLERS LOGPEACHY NO. 1-19

CASING RECORD:	OPERATOR: Campbell & Marden	DESCRIPTION:
8-5/8" @ 1764' w/700 sax cement	CONTRACTOR: Sage Drilling Co.	C NW¼ Sec. 19-34S-36W Stevens Co., Ks.
TOTAL DEPTH: 6875'	COMMENCED: March 8, 1973	ELEVATION: 3125KB
	COMPLETED: March , 1973	

<u>FORMATION</u>	<u>FROM</u>	<u>TO</u>	<u>REMARKS</u>
Sand	0	125	
Sand & Clay	125	557	
Clay & Red Bed	557	1117	
Red Bed	1117	1170	
Sand	1170	1420	
Shale	1420	1690	
Red Bed	1690	1767	
Shale & Lime	1767	2271	
Lime	2271	2530	
Shale & Lime	2530	2830	
Lime	2830	3360	
Lime & Shale	3360	3517	
Lime	3517	3645	
Lime & Shale	3645	3823	
Lime	3823	3871	
Shale & Lime	3871	3991	
Lime & Shale	3991	4353	
Shale & Lime	4353	4448	
Lime	4448	4569	
Lime & Shale	4569	4837	
Lime	4837	4937	
Lime & Shale	4937	5555	
Shale & Lime	5555	5694	
Shale	5694	5888	
Shale & Lime	5888	5988	
Shale	5988	6264	
Shale & Sand	6464	6329	
Lime	6329	6790	
Lime & Shale	6790	6875	D&A

RECEIVED
STATE CORPORATION COMMISSION
APR 4 1973
CONSERVATION DIVISION
Wichita, Kansas

I certify that this is a true and correct copy of the above log to the best of my knowledge.

SAGE DRILLING CO., INC.

By Clarence Michael
Clarence Michael

Subscribed and sworn to before me this 30th day of March, 1973.

Louise K. Whitted
Louise K. Whitted - Notary Public

My commission expires:
November 26, 1974.

