

STATE OF KANSAS
STATE CORPORATION COMMISSION

Form CP-4


Give All Information Completely
Make Required Affidavit
Mail or Deliver Report to:
Conservation Division
State Corporation Commission
212 No. Market
Wichita, Kansas

WELL PLUGGING RECORD

Stevens County, Sec. 11 Twp. 34S Rge. (E)36W (W)

Location as "NE/CNWxSWx" or footage from lines. NW/4
Lease Owner Beren Corporation
Lease Name Lewis #1 Well No. 11
Office Address 1130 Vickers KSB & T Building Wichita, Kansas 67202
Character of Well (completed as Oil, Gas or Dry Hole) dry
Date well completed May 2, 1973
Application for plugging filed 19
Application for plugging approved 19
Plugging commenced May 2, 1973
Plugging completed May 2, 1973
Reason for abandonment of well or producing formation

NORTH

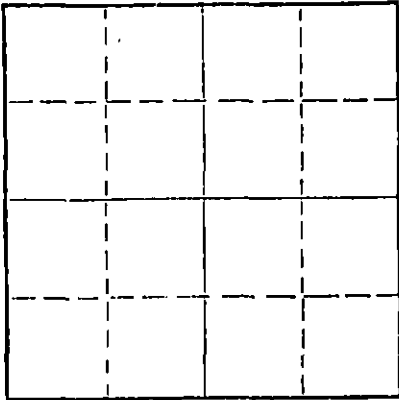

Locate well correctly on above Section Plat

If a producing well is abandoned, date of last production 19
Was permission obtained from the Conservation Division or its agents before plugging was commenced? Yes

Name of Conservation Agent who supervised plugging of this well
Producing formation Depth to top Bottom Total Depth of Well 6310 Feet
Show depth and thickness of all water, oil and gas formations.

OIL, GAS OR WATER RECORDS

CASING RECORD

FORMATION	CONTENT	FROM	TO	SIZE	PUT IN	PULLED OUT
				8 5/8"	1727'	

Describe in detail the manner in which the well was plugged, indicating where the mud fluid was placed and the method or methods used in introducing it into the hole. If cement or other plugs were used, state the character of same and depth placed, from feet to feet for each plug set.

100 sx. 2950'/2600'

35 sx. 1200'/1100'

15 sx. 45'/0

RECEIVED
STATE CORPORATION COMMISSION

MAY 9 1973

CONSERVATION DIVISION
Wichita, Kansas

(If additional description is necessary, use BACK of this sheet)

Name of Plugging Contractor Zenith Drilling Corporation, Inc.
Address 200 W. Douglas, Suite 600 Wichita, Kansas 67202

STATE OF Kansas, COUNTY OF Sedgwick, ss.
C. Robert Buford (employee of owner) or (owner/operator) of the above-described well, being first duly sworn on oath, says: That I have knowledge of the facts, statements, and matters herein contained and the log of the above-described well as filed and that the same are true and correct. So help me God.

(Signature) C. Robert Buford
200 W. Douglas, Suite 600 Wichita, Ks. 67202
(Address)

SUBSCRIBED AND SWORN TO before me this 4th day of May, 1973

Myrna S. Murphy
Notary Public.

My commission expires August 15, 1975

WELL LOG

COMPANY Beren Corporation

SEC. 11-34S-36W

FARM Lewis #1

NO. 11

LOC. NW/4


TOTAL DEPTH 6310'

COUNTY Stevens

COMM. 4-21-73

COMP. 5-2-73

CONTRACTOR Zenith Drilling Corporation, Inc.

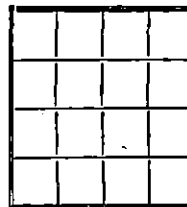

CASING

8 5/8" @ 1727' w/800 sx.

ELEVATION

PRODUCTION

FIGURES INDICATE BOTTOM OF FORMATIONS

- 1380' Red Bed, Anhydrite, Sand
- 2497' Red Bed, Anhydrite
- 2765' Shale
- 3380' Shale, Lime
- 5310' Lime
- 5880' Shale, Lime
- 6200' Shale
- 6310' Shale, Sand

RECEIVED
 STATE CORPORATION COMMISSION
 MAY 9 1973
 CONSERVATION DIVISION
 Wichita, Kansas

State of Kansas }
 County of Sedgwick } RS

I, C. Robert Buford, President, of Zenith Drilling Corporation, Inc.
 upon oath state the above and foregoing is a true and correct copy of the log of the Lewis #1-11 well.

C. Robert Buford

Subscribed and sworn to before me this 4th day of May, 1973.

My Commission Expires: August 15, 1975

Myrna S. Murphy
 NOTARY PUBLIC