

WELL PLUGGING RECORD

Give All Information Completely
Make Required Affidavit
Mail or Deliver Report to:
Conservation Division
State Corporation Commission
211 No. Broadway
Wichita, Kansas

Stevens County, Sec. 5 Twp. 34S Rge. 36W (E) (W)

Location as "NE/CNW/SW" or footage from lines C-NE-SW

Lease Owner Socony Mobil Oil Company, Inc.

Lease Name Alden W. Foster Well No. 1

Office Address 300 No. Broadway, Wichita, Kansas

Character of Well (completed as Oil, Gas or Dry Hole) Dry Hole

Date well completed October 15, 1965

Application for plugging filed October 19, 1965

Application for plugging approved October 20, 1965


Plugging commenced October 15, 1965

Plugging completed October 15, 1965

Reason for abandonment of well or producing formation Drilled Dry

If a producing well is abandoned, date of last production --- 19

Was permission obtained from the Conservation Division or its agents before plugging was commenced? Yes

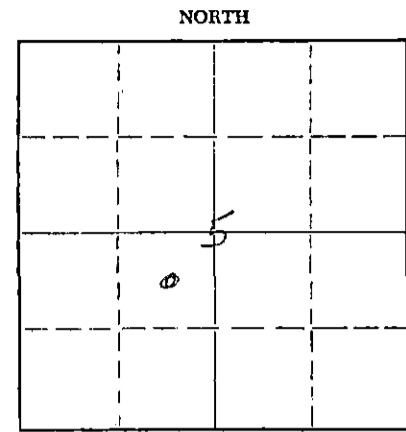

Locate well correctly on above Section Plat

Name of Conservation Agent who supervised plugging of this well Hugh Scott

Producing formation --- Depth to top --- Bottom --- Total Depth of Well 6910 Feet

Show depth and thickness of all water, oil and gas formations.

OIL, GAS OR WATER RECORDS

CASING RECORD

FORMATION	CONTENT	FROM	TO	SIZE	PUT IN	PULLED OUT
				8 5/8"	1764	NONE

Describe in detail the manner in which the well was plugged, indicating where the mud fluid was placed and the method or methods used in introducing it into the hole. If cement or other plugs were used, state the character of same and depth placed, from feet to feet for each plug set.

Howco plugged 7 7/8" hole at 2950 with 80 sacks common cement. Pulled up drill pipe to 1762' at base of 8 5/8" casing. Cement at 1762' with 50 sacks common cement. Top of cement at 1560'. Hole from 1560' to surface held for possible salt water disposal well.

STATE CORPORATION COMMISSION
OCT 21 1965
CONSERVATION DIVISION
WICHITA, KANSAS

(If additional description is necessary, use BACK of this sheet)

Name of Plugging Contractor Graham-Michaelis Drilling Co.
Address 211 No. Broadway, Wichita, Kansas

STATE OF KANSAS, COUNTY OF SEDGWICK, ss.
T. V. Herriage (employee of owner) or (owner or operator) of the above-described

well, being first duly sworn on oath, says: That I have knowledge of the facts, statements, and matters herein contained and the log of the above-described well as filed and that the same are true and correct. So help me God.

(Signature) T. V. Herriage Dist. Acctg. Group, Supr.
300 No. Broadway, Wichita, Kansas (Address)

SUBSCRIBED AND SWORN TO before me this 19th day of October, 1965.

Steve M. McFee Notary Public

My commission expires 7-2-69



ALDEN W. FOSTER #1

WELL RECORD:

LOCATION:

C NE SW Section 5-34S-36W
Stevens County, Kansas

Commenced: 9-24-65
Completed: 10-15-65
(Rotary)

CONTRACTOR:

Graham-Michaelis Drilling, Inc.
Liberal Division
P. O. Box 1294
Liberal, Kansas 67901

CASING RECORD:

57 Joints 8-5/8" 24# Casing
Cemented w/400 sx Common 12% Gel
2% cc followed w/100 sx Common
2% cc

	<u>LOG</u>
Sand, Clay & Red Bed	0 - 1015
Red Bed & Sand	1015 - 1665
Red Bed	1665 - 1715
Stone Corral	1715 - 1765
Red Bed & Clay	1765 - 1950
Red Bed	1950 - 2410
Shale & Lime	2410 - 3188
Lime	3188 - 3296
Lime & Shale	3296 - 4192
Lime	4192 - 4390
Lime & Shale	4390 - 4500
Lime	4500 - 4593
Lime & Shale	4593 - 4840
Lime	4840 - 5028
Lime & Shale	5028 - 5195
Lime	5195 - 5293
Lime & Shale	5293 - 6591
Lime	6591 - 6625

RECEIVED
STATE CORPORATION COMMISSION

OCT 25 1965

CONSERVATION DIVISION
Topeka, Kansas

6910' - Total Rotary Depth

The undersigned, Graham-Michaelis Drilling, Inc., Liberal Division, certifies that the above log is a true and correct copy of the formations encountered in drilling the above mentioned well, as taken from the Daily Drilling Report.

GRAHAM-MICHAELIS DRILLING, INC.
LIBERAL DIVISION


H. R. Michaelis