

STATE OF KANSAS  
STATE CORPORATION COMMISSION  
Give All Information Completely  
Make Required Affidavit  
Mail or Deliver Report to:  
Conservation Division  
State Corporation Commission  
212 No. Market  
Wichita, Kansas

O: KCC  
c: KGS  
CBS  
WBH  
ERN  
File

WELL PLUGGING RECORD

Stevens County, Sec. 25 Twp. 34S Rge. (E) 37 (W)

Location as "NE/CNW%SW%" or footage from lines 2310' From N Line 330' From E Line

Lease Owner Mobil Oil Corporation

Lease Name Cunningham Unit #2 Well No. 3

Office Address P. O. BOX 5444, Denver, Colorado 80217

Character of Well (completed as Oil, Gas or Dry Hole) Dry Hole

Date well completed October 30 1978

Application for plugging filed 1978

Application for plugging approved November 3 1978


Plugging commenced October 30 1978

Plugging completed October 30 1978

Reason for abandonment of well or producing formation Dry Hole

If a producing well is abandoned, date of last production 1978

Was permission obtained from the Conservation Division or its agents before plugging was commenced?

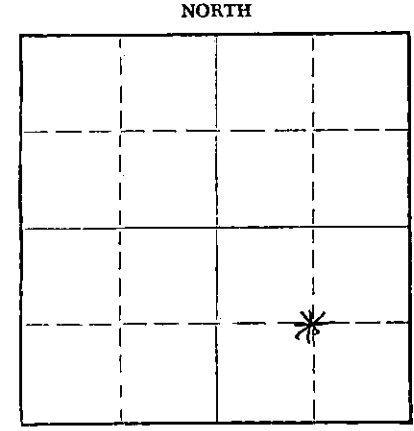

Locate well correctly on above Section Plat

Name of Conservation Agent who supervised plugging of this well Clarence Thomas

Producing formation Depth to top Bottom Total Depth of Well 6930 Feet

Show depth and thickness of all water, oil and gas formations.

OIL, GAS OR WATER RECORDS CASING RECORD

| FORMATION | CONTENT | FROM | TO   | SIZE   | PUT IN | PULLED OUT         |
|-----------|---------|------|------|--------|--------|--------------------|
| Glorieta  | Sand    | 0    | 1752 | 8-5/8" | 1752   | 0' casing cemented |
|           |         |      |      |        |        |                    |
|           |         |      |      |        |        |                    |
Describe in detail the manner in which the well was plugged, indicating where the mud fluid was placed and the method or methods used in introducing it into the hole. If cement or other plugs were used, state the character of same and depth placed, from feet to feet for each plug set.

- 1 St. Plug 25 sacks cement @ 6813'
- 2 Nd. Plug 25 " " @ 6465'
- 3 Rd. Plug 25 " " @ 6378'
- 4 Th. Plug 25 " " @ 6010'
- 5 Th. Plug 25 " " @ 4360'
- 6 Th. Plug 25 " " @ 2850'
- 7 Th. Plug 35 " " @ 1700'
- 8 Th. Plug 10 " " @ 4' to 0

RECEIVED  
STATE CORPORATION COMMISSION  
NOV 10 1978  
11-16-78  
CONSERVATION DIVISION  
WICHITA, KANSAS

(If additional description is necessary, use BACK of this sheet)

Name of Plugging Contractor Zenith Drilling Corporation, Inc.  
Address 200 W. Douglas, Wichita, Kansas 67202

STATE OF Colorado, COUNTY OF Denver, ss.  
C. J. Park (employee of owner) or (owner or operator) of the above-described well, being first duly sworn on oath, says: That I have knowledge of the facts, statements, and matters herein contained and the log of the above-described well as filed and that the same are true and correct. So help me God.

(Signature) C. J. Park

P. O. BOX 5444, Denver, Colorado 80217 (Address)

SUBSCRIBED AND SWORN to before me this 14th day of November, 1978

My Commission expires October 26, 1981

Sharon E. Fullman Notary Public.

My commission expires

# WELL LOG

COMPANY Mobil Oil Corporation

SEC. 25-34S-37W

FARM Cunningham Unit #2 NO. 3

LOC. SE SE NE


TOTAL DEPTH 6930

COUNTY Stevens, Kansas

COMM. 10-13-78

COMP. 10-30-78

CONTRACTOR ZENITH DRILLING CORPORATION, INC.

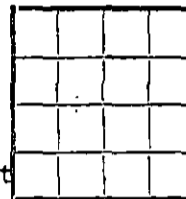

**CASING**

1752' of 8 5/8" casing, cemented with 750 sacks cement

ELEVATION

PRODUCTION

FIGURES INDICATE BOTTOM OF FORMATIONS

|       |                           |
|-------|---------------------------|
| 350'  | Clay & Sand               |
| 1135' | Clay, Sand & Red Bed      |
| 1528' | Red Bed & Sand            |
| 1754' | Sand, Red Bed & Anhydrite |
| 6930' | Lime & Shale              |

### PLUGGING INFORMATION

|          |                   |
|----------|-------------------|
| 1st Plug | 25 sacks at 6813' |
| 2nd Plug | 25 sacks at 6465' |
| 3rd Plug | 25 sacks at 6378' |
| 4th Plug | 25 sacks at 6010' |
| 5th Plug | 25 sacks at 4360' |
| 6th Plug | 25 sacks at 2850' |
| 7th Plug | 35 sacks at 1700' |
| 8th Plug | 10 sacks 4' to 0' |

Job complete at 2:00 P.M. - 10/30/78.

RECEIVED  
STATE CORPORATION COMMISSION

NOV - 9 1978

CONSERVATION DIVISION  
Wichita, Kansas

State of KANSAS }  
County of SEDGWICK } SS

I, Emmet E. Hall of Zenith Drilling Corporation, Inc.

upon oath state the above and foregoing is a true and correct copy of the log of the Cunningham Unit #3 well #2.

Subscribed and sworn to before me this 1st day of November, 19 78

My Commission Expires: December 15, 1980

Sharon R. Allen  
Sharon R. Allen NOTARY PUBLIC