


STATE OF KANSAS
STATE CORPORATION COMMISSION

WELL PLUGGING RECORD

Give All Information Completely
Make Required Affidavit
Mail or Deliver Report to:
Conservation Division
State Corporation Commission
800 Bittling Building
Wichita, Kansas

NORTH

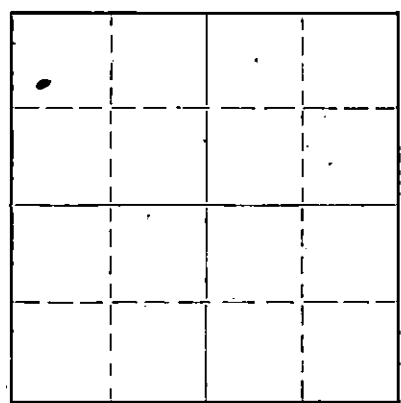

Locate well correctly on above
Section Plat

Sumner County. Sec. NW 10 Twp. Rge. 35 (E) 2 (W)
Location as "NE/CNW/SW" or footage from lines 390' From W. 990' from N.
Lease Owner Champlin Refining Company
Lease Name Slentz Well No. 2
Office Address Enid, Oklahoma
Character of Well (completed as Oil, Gas or Dry Hole) Dry Hole
Date well completed February 26, 1950
Application for plugging filed Yes 1952
Application for plugging approved Yes 1952
Plugging commenced July 6, 1952
Plugging completed July 14, 1952
Reason for abandonment of well or producing formation Dry Hole

If a producing well is abandoned, date of last production None 19
Was permission obtained from the Conservation Division or its agents before plugging was commenced? Yes W. G. Buffington

Name of Conservation Agent who supervised plugging of this well W. G. Buffington
Producing formation Dry Depth to top Bottom Total Depth of Well 4953 Feet
Show depth and thickness of all water, oil and gas formations.

OIL, GAS OR WATER RECORDS

CASING RECORD

Formation	Content	From	To	Size	Put In	Pulled Out
				10-3/4"	959'	None
				7"	### ### 4710'	3311'

Describe in detail the manner in which the well was plugged, indicating where the mud fluid was placed and the method or methods used in introducing it into the hole. If cement or other plugs were used, state the character of same and depth placed, from feet to feet for each plug set.

14 sacks of cement in bottom of hole with dump bailer. Filled pipe with rotary mud. Shot pipe off at 3311'. Kept hole loaded while pulling casing. Used 20 sacks at 959' at bottom of surface. Used 10 sacks of cement at top of hole to cap hole.

(If additional description is necessary, use BACK of this sheet)

Correspondence regarding this well should be addressed to Champlin Refining Company
Address Enid, Oklahoma

STATE OF Oklahoma COUNTY OF Garfield, SS.
W. W. Oberlander (employee of owner) or (owner or operator) of the above-described well,
being first duly sworn on oath, says: That I have knowledge of the facts, statements, and matters herein contained and the log of the above-described well as filed and that the same are true and correct. So help me God.

(Signature) W. W. Oberlander

(Address)

SUBSCRIBED AND SWORN to before me this 21 day of July, 1952

My commission expires 5-24-53

[Signature]
Notary Public.

PLUGGING
FILE SEC 10 T 35 R 20
BOOK PAGE 24 LINE 31

STATE CORPORATION COMMISSION
7-24-52
JUL 24 1952

CONSERVATION DIVISION
Wichita, Kansas


WELL LOG BUREAU - KANSAS GEOLOGICAL SOCIETY 15-191-01577-0000
 508 East Murdock Wichita, Kansas

Company - CHAMPLIN REFINING COMPANY
 Farm - Slentz No. 2

SEC. 10 T. 35 R. 2W
 SW N W NW
 330' W. L. & 990' N. L.
 of NW/4

Total Depth. 4990
 Comm. 1-8-50 Comp. 5-6-50
 Shot or Treated.
 Contractor.
 Issued. 6-10-50

County. Sumner
 KANSAS

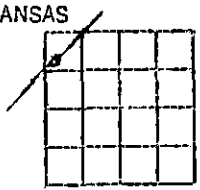

Elevation. _____

Production. SWDW

CASING:
 10 3/4" 959' com. w/5005 sx
 7" 4710' com. w/300 sx

Figures Indicate Bottom of Formations.

redbed	130	sand	4766
shale & shells	820	sandy shale	4722
shale & lime		shale	4805
shells	959	sand (hard)	4814
lime	980	shale	4829
shale & lime	1280	sand	4846
shale & sand	1500	shale	4859
shale & lime	1812	sand	4999
shale & sand	1940	lime	4912
sand, lime & shale	2220	lime	4990
savoy lime	2315	Total depth	
lime	2375		
lime & shale	2445	<u>Geological Tops:</u>	
lime & sand	2520	Topeka	2225
sand & shale	2595	Oread	2625
shale & lime	2760	Tonkawa-Stal.	3062
shale	2820	Layton	3462
shale & lime streaks	2855	Big Ls-Osw	3828
shale & lime	2925	Miss. chat	4243
shale, sdy limo	2985	Miss. Ls.	4270
lime & shale	3040	B. Miss. & Top	
shale & lime, sand	3105	Kinderhook	4636
sand (no odor)	3162	Woodford	4680
shale & sand	3195	Viola	4701
sand & shale	3350	Simpson	4709
shale	3420	Arbuckle	4906
shale & sand	3495		
sand	3569		
sandy shale	3580		
sandy limo	3595		
sandy limo & shale	3665		
shale	3715		
lime	3795		
shale & lime	3840		
lime	3965		
lime & shale	4040		
shale	4095		
shale & sand	4140		
shale	4185		
shale & lime	4250		
chert limo	4315		
lime	4349		
chert-limo	4377		
lime	4391		
lime & chert	4415		
lime	4583		
lime & shale	4619		
lime & chert	4627		
lime & shale	4710		

PLUGGING
 FILE SEC 10 T 35 R 2W
 PAGE 26 LINE 31