


STATE OF KANSAS
STATE CORPORATION COMMISSION

WELL PLUGGING RECORD

Give All Information Completely
Make Required Affidavit
Mail or Deliver Report to:
Conservation Division
State Corporation Commission
800 Bittling Building
Wichita, Kansas

NORTH

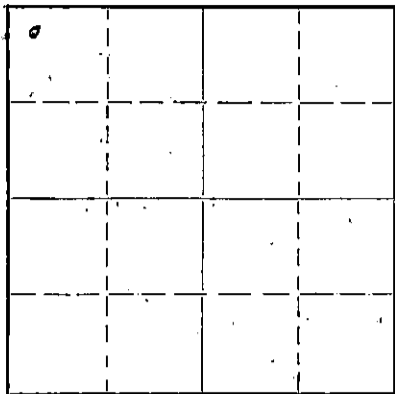

Locate well correctly on above
Section Flat

Sumner County. Sec. NW10 or wp. Rge. 35 (E) 2 (W)
Location as "NE/CNW $\frac{1}{4}$ SW $\frac{1}{4}$ " or footage from lines NW of NW 330' Corner Location
Lease Owner Champlin Refining Company
Lease Name Slentz Well No. 1
Office Address Enid, Oklahoma
Character of Well (completed as Oil, Gas or Dry Hole) Oil
Date well completed November 3, 1949
Application for plugging filed Yes 1952
Application for plugging approved Yes 1952
Plugging commenced June 30, 1952
Plugging completed July 5, 1952
Reason for abandonment of well or producing formation Went to saltwater.

If a producing well is abandoned, date of last production December 28 1952
Was permission obtained from the Conservation Division or its agents before plugging was commenced? Yes

Name of Conservation Agent who supervised plugging of this well W. G. Buffington
Producing formation Simpson Depth to top 4711 Bottom 4715 Total Depth of Well 4719 Feet
Show depth and thickness of all water, oil and gas formations.

OIL, GAS OR WATER RECORDS

CASING RECORD

| Formation | Content | From | To | Size | Put In | Pulled Out |
|-----------|---------|------|----|---------|--------|------------|
| | | | | 10-3/4" | 201' | None |
| | | | | 7" | 4711' | 3510' |
| | | | | | | |
| | | | | | | |
| | | | | | | |
| | | | | | | |
| | | | | | | |

Describe in detail the manner in which the well was plugged, indicating where the mud fluid was placed and the method or methods used in introducing it into the hole. If cement or other plugs were used, state the character of same and depth placed, from _____ feet to _____ feet for each plug set.

Cement from 4719' back to 4698'. 13' of cement in bottom of pipe. 20 sacks of cement run.
Filled pipe with rotary mud. Shot pipe off at 3510'. Keep hole loaded while pulling casing. Used 20 sacks of cement at bottom of surface pipe. Used 10 sacks of cement at top of hole to cap hole with.

(If additional description is necessary, use BACK of this sheet)

Correspondence regarding this well should be addressed to Champlin Refining Company
Address Enid, Oklahoma

STATE OF Oklahoma COUNTY OF Garfield, ss.
W. W. Oberlander (employee of owner) or (owner or operator) of the above-described well,
being first duly sworn on oath, says: That I have knowledge of the facts, statements, and matters herein contained and the log of the above-described well as filed and that the same are true and correct. So help me God.

(Signature) W. W. Oberlander

(Address) _____

SUBSCRIBED AND SWORN to before me this 21 day of July, 1952

My commission expires 5-21-53

22-5133-s 9-42-10M

RECEIVED
STATE CORPORATION COMMISSION
Notary Public.

JUL 24 1952

CONSERVATION DIVISION
Wichita, Kansas

PLUGGING
FILE SEC 10-35-R-20
BOOK PAGE 26 LINE 30


WELL LOG BUREAU -- KANSAS GEOLOGICAL SOCIETY
508 E. Murdock, Wichita, Kansas

Company - CHAMPLIN REFINING CO.
Farm - Slentz No. 1

SEC. ¹⁰ 3 T. 35 R. 2W
NW NW NW
330' FNL, 330' FWL of NW 1/4

Total Depth. 4719
Comm. 8-27-49 Comp. 10-24-49
Shot or Treated.
Contractor.
Issued. 10-14-50

County. Sumner

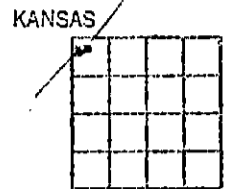

CASING:
10 3/4" 201' cem w/140 sx.
7" 4711' cem w/300 sx.

Elevation. 1124 DF

Production. 1298 bbls.

Figures Indicate Bottom of Formations.

| | |
|-------------------------|------|
| shale, shells | 225 |
| shale, gravel | 320 |
| shale, shells, anhyd | 660 |
| anhyd., shale, shale? | 820 |
| shale, anhyd. | 880 |
| shale, shells, salt | 1110 |
| shale, gyp, lime shells | 1220 |
| lime, shale | 1465 |
| shale | 1485 |
| shale lime brkn, sand | |
| strks. | 1615 |
| shale lime sdy | 1735 |
| lime, sand, shale | 1900 |
| lime, shells, shale | 1975 |
| lime sdy, shale | 2320 |
| lime, shale | 2770 |
| sand strks, shale | 2825 |
| lime, shale | 2930 |
| shale | 2985 |
| shale, sand | 3110 |
| lime sdy, shale | 3180 |
| lime, shale | 3240 |
| shale | 3455 |
| shale, sand | 3545 |
| lime, shale | 3880 |
| lime | 3935 |
| lime, shale | 4225 |
| shale, chert | 4260 |
| shale, chat | 4283 |
| chat | 4305 |
| lime, chert | 4323 |
| lime, shale, chert | 4345 |
| lime | 4365 |
| lime, chert | 4400 |
| lime | 4415 |
| lime, chert | 4440 |
| lime | 4519 |
| lime, chert | 4524 |
| lime | 4570 |
| lime, shale | 4610 |
| lime | 4635 |
| lime, shale | 4710 |
| lime, sand | 4719 |
| Total depth | |

| | |
|-------------------|------|
| Tops: | |
| Topeka | 2240 |
| Stalnaker | 3060 |
| Big Lime (Oswego) | 3825 |
| Miss, chat | 4256 |
| Viola | 4707 |
| Wilcox sand | 4709 |

PLUGGING
FILE SEC 10 T 35 R 2W
BOOK PAGE 26 LINE 30