


Q

STATE OF KANSAS
STATE CORPORATION COMMISSION

Give All Information Completely
Make Required Affidavit
Mail or Deliver Report to:
Conservation Division
State Corporation Commission
211 No. Broadway
Wichita, Kansas

WELL PLUGGING RECORD

NORTH

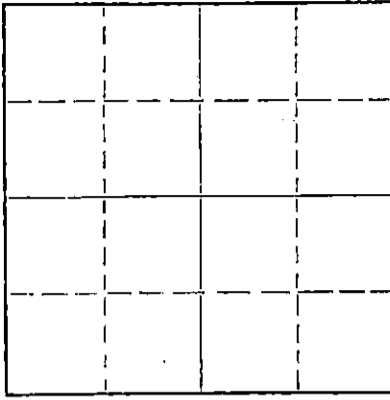

Locate well correctly on above
Section Plat

Sumner County, Sec. 9 Twp. 35S Rge. 2 (W)

Location as "NE/CNW/SW" or footage from lines 150' NE of C NE SW

Lease Owner Jones-Gebert Oil Co.

Lease Name White Well No. 1

Office Address 1007 Central Bldg. - Wichita 2, Kansas

Character of Well (completed as Oil Gas or Dry Hole) Dry Hole

Date well completed February 9 1962

Application for plugging filed February 9 1962

Application for plugging approved February 9 1962

Plugging commenced February 9 1962

Plugging completed February 9 1962

Reason for abandonment of well or producing formation Dry Hole

If a producing well is abandoned, date of last production 19

Was permission obtained from the Conservation Division or its agents before plugging was commenced? Yes

Name of Conservation Agent who supervised plugging of this well Mr. Eugene Graham

Producing formation Depth to top Bottom Total Depth of Well 4781 Feet

Show depth and thickness of all water, oil and gas formations.

OIL, GAS OR WATER RECORDS

CASING RECORD

FORMATION	CONTENT	FROM	TO	SIZE	PUT IN	PULLED OUT
				8-5/8"	215'	

Describe in detail the manner in which the well was plugged, indicating where the mud fluid was placed and the method or methods used in introducing it into the hole. If cement or other plugs were used, state the character of same and depth placed, from feet to feet for each plug set.

Set plug @ 198' with 1/2 sx. hulls and 10 sx. cement; mud to 35'; set plug with 1/2 sx. hulls and 8 sx. cement; used 2 sx. cement in rat hole.

RECEIVED
STATE CORPORATION COMMISSION
FEB 13 1962
CONSERVATION DIVISION
Wichita, Kansas

(If additional description is necessary, use BACK of this sheet)


Name of Plugging Contractor Jones-Gebert Oil, Inc.
Address 1007 Central Bldg. - Wichita 2, Kansas

STATE OF Kansas, COUNTY OF Sedgwick, ss.
George R. Jones (employee of owner) or (owner or operator) of the above-described well, being first duly sworn on oath, says: That I have knowledge of the facts, statements, and matters herein contained and the log of the above-described well as filed and that the same are true and correct. So help me, God.

(Signature) George R. Jones
1007 Central Bldg. - Wichita 2, Kansas
(Address)

Subscribed and sworn to before me this 12th day of February, 1962
My commission expires February 1, 1964

Barbara J. Layton
Barbara J. Layton Notary Public.

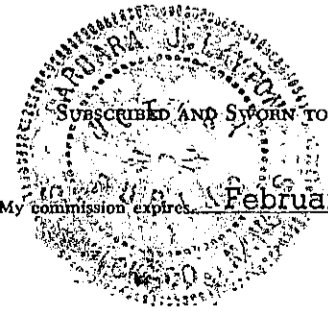

15-191-00233-0000
R

DRILLERS' LOG

Company:	Jones-Gebert Oil, Inc.
Contractor:	Jones-Gebert Oil, Inc.
Farm:	White #1
Location:	150' NE of C NE SW Sumner County, Kansas
Commenced:	1/17/62
Completed:	2/9/62
Casing:	8-5/8" @215' W/175 sx.

0 - 50	Surface Clay
50 - 212	Surface hole
212 - 575	Shale and shells
575 - 715	Shale w/lime streaks
715 - 1015	Shale and lime
1015 - 1220	Lime w/shale streaks
1220 - 1375	Shale and lime
1375 - 1525	Lime and shale
1525 - 1825	Shale
1825 - 1980	Shale w/lime streaks
1980 - 2190	Shale and lime
2190 - 2360	Lime and shale streaks
2360 - 2475	Lime and shale
2475 - 2605	Lime w/shale streaks
2605 - 2675	Lime and shale
2675 - 2790	Lime and shale streaks
2790 - 2880	Lime and shale
2880 - 2958	Lime and shale
2958 - 3023	Lime and shale streaks
3023 - 3090	Shale and lime
3090 - 3110	Sand and shale
3110 - 3180	Sand - Stalnaker
3180 - 3260	Sand w/shale streaks
3260 - 3320	XXXXXXXXXX
3260 - 3320	Lime and shale
3320 - 3425	Shale and lime streaks
3425 - 3501	Shale and lime
3501 - 3505	Shale and lime
3505 - 3580	Layton sand
3580 - 3595	K. C. lime
3595 - 3688	K.C. lime
3688 - 3770	Lime
3770 - 3828	K.C. lime
3828 - 3908	Lime and shale
3908 - 3990	Lime w/shale
3990 - 4045	Shale and lime
4045 - 4103	Shale and lime
4103 - 4195	Shale and lime
4195 - 4275	Shale and lime
4275 - 4305	Shale and lime
4305 - 4321	Miss. lime and chert
4321 - 4345	Miss. lime
4345 - 4404	Miss. chert
4404 - 4428	Miss. chert
4428 - 4463	Miss. lime and chert
4463 - 4499	Miss. lime and chert
4499 - 4520	Miss.
4520 - 4532	Miss. lime
4532 - 4561	Miss.
4561 - 4575	Miss.
4575 - 4603	Miss.
4603 - 4615	Miss. lime and chert
4615 - 4648	Miss. lime

RECEIVED
STATE CORPORATION COMMISSION
FEB. 13 1962
CONSERVATION DIVISION
Wichita, Kansas

4648 -	4668	Miss.
4668 -	4696	Shale
4696 -	4716	Shale
4716 -	4740	Shale and dolomite
4740 -	4750	Viola lime
4750 -	4754	Simpson zone
4754 -	4755	Simpson zone
4755 -	4763	Simpson sand
4763 -	4765	Simpson sand
4765 -	4781	Simpson T.D.
	4781	Rotary Total Depth

I, George R. Jones, do hereby certify that the above and foregoing is a true and correct copy of the log of the #1 White, 150 ft. NE of C NE SW, Sec. 9-35S-2W, Sumner County, Kansas as reflected by the files of Jones-Gebert Oil, Inc.

George R. Jones

George R. Jones

State of Kansas (County of Sedgwick) ss:
Subscribed and sworn to before me, a Notary Public, in and for Sedgwick County, Kansas, this 9th day of February, 1962.

My Commission Expires: February 1, 1964

Barbara J. Layton

Barbara J. Layton, Notary Public

RECEIVED
STATE CORPORATION COMMISSION
FEB 1 1962
CONSERVATION DIVISION
Wichita, Kansas