15-191-20072-0000


STATE OF KANSAS
STATE CORPORATION COMMISSION

Form CP-4

Give All Information Completely
Make Required Affidavit
Mail or Deliver Report to:
Conservation Division
State Corporation Commission
212 No. Market
Wichita, Kansas

WELL PLUGGING RECORD

NORTH

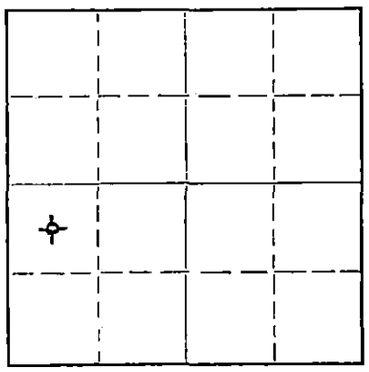

Locate well correctly on above Section Plat

Sumner County. Sec. 5 Twp. 35S Rge. 2 (E) (W)

Location as "NE/CNW¼SW¼" or footage from lines C NW SW

Lease Owner W. C. Pickens

Lease Name STEPHENS Well No. 1

Office Address 2000 Fidelity Union Tower, Dallas, Texas

Character of Well (completed as Oil, Gas or Dry Hole) Dry Hole

Date well completed May 20, 1968 19

Application for plugging filed verbally on May 19th, 1968 19

Application for plugging approved May 19, 1968 19

Plugging commenced May 20, 1968 8:00 am 19

Plugging completed May 20, 1968 9:15 am 19

Reason for abandonment of well or producing formation Dry hole - porous zones contain water

If a producing well is abandoned, date of last production 19

Was permission obtained from the Conservation Division or its agents before plugging was commenced? Yes

Name of Conservation Agent who supervised plugging of this well Mr. Howard Ness, Winfield, Kansas

Producing formation None Depth to top Bottom Total Depth of Well 4816' Feet

Show depth and thickness of all water, oil and gas formations.

OIL, GAS OR WATER RECORDS — CASING RECORD

FORMATION	CONTENT	FROM	TO	SIZE	PUT IN	PULLED OUT
Stalnaker Sand	Water	3168	3297			
Layton Sand	Water	3560	3620			
Mississippian Chat	Water	4332	4374			
Simpson Sand	Water	4781	4816			

Describe in detail the manner in which the well was plugged, indicating where the mud fluid was placed and the method or methods used in introducing it into the hole. If cement or other plugs were used, state the character of same and depth placed, from feet to feet for each plug set.

Heavy mud T.D. to 300'
½ Sack hulls & Halliburton plug at 300'. Circ. mud & plug held
20 sacks cement
Heavy mud to 40'
½ sack hulls and Halliburton plug bridged with kelly
8 sacks cement
2 sacks cement in rat hole

RECEIVED
STATE CORPORATION COMMISSION
MAY 23 1968
CONSERVATION DIVISION
Wichita, Kansas

(If additional description is necessary, use BACK of this sheet)

Name of Plugging Contractor Sage Drilling Company

Address 500 Bitting Building - Wichita, Kansas

STATE OF TEXAS, COUNTY OF DALLAS, ss.

John C. Roberts (employee of owner) ~~or (owner or operator)~~ of the above-described well, being first duly sworn on oath, says: That I have knowledge of the facts, statements, and matters herein contained and the log of the above-described well as filed and that the same are true and correct. So help me God.

(Signature) John C. Roberts

W. C. Pickens - 2000 Fidelity Union Tower - Dallas Texas
(Address)

SUBSCRIBED AND SWORN TO before me this 21st day of May, 19 68

Bonita Pierson
Bonita Pierson Notary Public.

My commission expires June 1st, 1969

15-191-20072-0000

DRILLERS LOG

J. H. STEPHENS NO. 1

CASING RECORD:
8-5/8" @ 294'
w/235 sax Cement

TOTAL DEPTH:
4816'

OPERATOR: W. C. Pickens
CONTRACTOR: Sage Drilling Co.
COMMENCED: May 7, 1968
COMPLETED: May 20, 1968

DESCRIPTION:
C NW SW
Sec. 5-35S-2W
Sumner County, Kansas

FORMATION	FROM	TO	REMARKS
Top Soil, Clay & Red Bed	0	295	
Shale & Lime	295	600	
Lime & Shale	600	1320	
Shale & Lime	1320	1790	
Lime & Shale	1790	2530	
Shale & Lime	2530	2745	
Lime & Shale	2745	2975	
Lime	2975	3076	
Shale & Lime	3076	3360	
Lime & Shale	3360	4178	
Shale & Lime	4178	4030	
Mississippi Chert & Lime	4030	4514	
Lime	4514	4546	
Lime & Chert	4546	4564	
Chert & Shale	4564	4602	
Lime	4602	4637	
Shale & Lime	4637	4677	
Chert, Lime & Shale	4677	4701	
Lime & Shale	4701	4778	
Simpson Sand	4778	4816	D&A

RECEIVED
STATE CORPORATION COMMISSION
MAY 22 1968
CONSERVATION DIVISION
Wichita, Kansas

I certify that this is a true and correct copy of the above log to the best of my knowledge.

SAGE DRILLING CO., INC.

By Wayne W. Kahmeyer
Wayne W. Kahmeyer

LOUISE K. WHITTED NOTARY PUBLIC SEDGWICK CO., KANS.

Subscribed and sworn to before me this 21st day of May, 1968.

Louise K. Whitted
Louise K. Whitted, Notary Public

My commission expires:
November 26, 1970.