


STATE OF KANSAS
STATE CORPORATION COMMISSION

WELL PLUGGING RECORD

Give All Information Completely
Make Required Affidavit
Mail or Deliver Report to
Conservation Division
State Corporation Comm.
245 North Water
Wichita, KS 67202

Location as Sumner County. Sec. 13 Twp. 35S Rge. 1W E/W
Location as "NE/CNW/SW" or footage from lines
NE SE SW

Lease Owner F & M Oil Co., Inc.
Lease Name Crow Well No. 1
Office Address 422 Union Center, Wichita, Ks. 67202
Character of Well (Completed as Oil, Gas or Dry Hole) dry

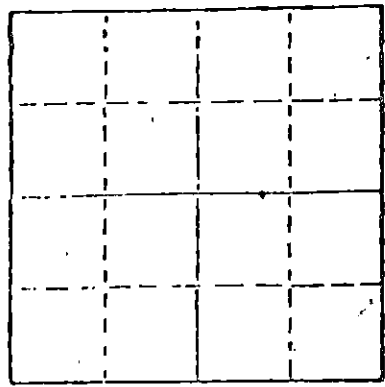

Locate well correctly on above
Section Plat

Date Well completed 5-2-81 19
Application for plugging filed 5-2-81 19
Application for plugging approved 5-2-81 19
Plugging commenced 5-2-81 19
Plugging completed 5-2-81 19
Reason for abandonment of well or producing formation _____

If a producing well is abandoned, date of last production _____ 19

Was permission obtained from the Conservation Division or its agents before plugging was commenced? yes

Name of Conservation Agent who supervised plugging of this well Carl Barnett
Producing formation _____ Depth to top _____ Bottom _____ Total Depth of Well 4035
Show depth and thickness of all water, oil and gas formations.

OIL, GAS OR WATER RECORDS

CASING RECORD

FORMATION	CONTENT	FROM	TO	SIZE	PUT IN	PULLED OUT

Describe in detail the manner in which the well was plugged, indicating where the mud fluid was placed and the method or methods used in introducing it into the hold. If cement or other plugs were used, state the character of same and depth placed, from _____ feet to _____ feet for each plug set.

Plug set 310' with 35 sks cement
Plug set 50' with 155 sks cement
3 sks cement in rat hole

RECEIVED

(If additional description is necessary, use BACK of STATE CORPORATION COMMISSION)

Name of Plugging Contractor Triangle Drilling & Exploration Co., Inc.
2200 W. 6th, El Dorado, Kansas 67042 MAY 11 1981

STATE OF Kansas COUNTY OF Butler CONSERVATION DIVISION
Wichita, Kansas
John S. Crowe (employee of owner) or (owner or operator)

of the above-described well, being first duly sworn on oath, says: That I have knowledge of the facts, statements, and matters herein contained and the log of the above-described well as filed and that the same are true and correct. So help me God.

(Signature) [Signature]
Triangle Drilling & Expy. Co., Inc.
2200 W. 6th, El Dorado, Kansas 67042
(Address)

SUBSCRIBED AND SWORN TO before me this 5th day of May, 19 81

VIOLET I. CROWE
NOTARY PUBLIC
STATE OF KANSAS
MY APPT. EXP. 3-23-85

[Signature]
Violet I. Crowe Notary Public.

My commission expires _____

WELL LOG

Operator F & M Oil Co., Inc.
 Comm _____ Comp _____
 Shot _____ Qts. From _____ ft. To _____ ft.
 Acidized _____ Gal. _____
 Prod. Formation _____
 Initial Prod. _____
 Elevation _____

Lease Crow Well No. 1
 Loc NE SE SW Sec 13 Twp 35S Rge 1W
 County Sumner State Kansas
 Contractor Triangle Drlg & Expl

Casing Record			
Size	Ft.	Pulled	Remarks
8 5/8	320	110	skc cement

FIGURES INDICATE BOTTOM OF FORMATION

0	-----	320	Surface
320	-----	568	Shale
568	-----	913	Shale
913	-----	1074	Shale & Lime Stks
1074	-----	1341	Sandy Shale & Lime Stks
1341	-----	1944	Shale & Lime
1944	-----	2332	Shale & Lime
2332	-----	2653	Lime & Shale
2653	-----	3036	Lime & Shale
3036	-----	3128	Shale
3128	-----	3273	Shale & Lime Stks
3273	-----	3341	Shale & Lime
3341	-----	3458	Lime
3458	-----	3506	Lime & Shale
3506	-----	3624	Lime & Shale
3624	-----	3640	Lime
3640	-----	3699	Shale
3699	-----	3720	Mississippi
3720	-----	3757	Mississippi Lime
3757	-----	3789	Lime
3789	-----	3911	Lime
3911	-----	3953	Lime
3953	-----	4035	Lime & Shale RTD

RECEIVED
 STATE CORPORATION COMMISSION

MAY 11 1981

CONSERVATION DIVISION
 Wichita, Kansas