

STATE OF KANSAS  
STATE CORPORATION COMMISSION

WELL PLUGGING RECORD

Give All Information Completely  
Make Required Affidavit  
Mail or Deliver Report to:  
Conservation Division  
State Corporation Commission  
800 Bittling Building  
Wichita, Kansas

Summer

County. Sec. 12 Twp. 35S Rge. 1W (E) (W)

Location as "NE/CNW/SW" or footage from lines SE SE SE

Lease Owner A. W. Holiday

Lease Name Strickland Well No. 1

Office Address Osage Hotel, Arkansas City, Kansas

Character of Well (completed as Oil, Gas or Dry Hole) Dry Hole

Date well completed February 6 19 55

Application for plugging filed February 9 19 55

Application for plugging approved 19


Plugging commenced February 6 19 55

Plugging completed February 6 19 55

Reason for abandonment of well or producing formation D & A

If a producing well is abandoned, date of last production 19

Was permission obtained from the Conservation Division or its agents before plugging was commenced? Yes

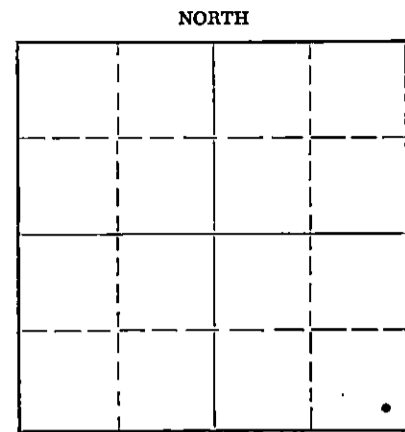

Locate well correctly on above  
Section Plat

Name of Conservation Agent who supervised plugging of this well William Buffington - State Pluggger

Producing formation \_\_\_\_\_ Depth to top \_\_\_\_\_ Bottom \_\_\_\_\_ Total Depth of Well 4576 Feet

Show depth and thickness of all water, oil and gas formations.

OIL, GAS OR WATER RECORDS

CASING RECORD

FORMATION	CONTENT	FROM	TO	SIZE	PUT IN	PULLED OUT
Stalnaker Sand		2675	2860			
Layton Sand		3095	3220			
Kansas City Lime		3340	3403			
Oswego Lime		3460	3580			
Mississippi Lime		3718	3914			
Simpson Sand		4010	4033			

Describe in detail the manner in which the well was plugged, indicating where the mud fluid was placed and the method or methods used in introducing it into the hole. If cement or other plugs were used, state the character of same and depth placed, from \_\_\_\_\_ feet to \_\_\_\_\_ feet for each plug set.

Mud to 350' - Halliburton plug - 15 sks of cement  
Mud to 30' - Halliburton plug - 10 sks of cement  
Pipe cut off below plow depth -  
Steel cap welded on

2-12-55

(If additional description is necessary, use BACK of this sheet)

Name of Plugging Contractor L. C. Smitherman Drilling Company  
Address Box 627, Augusta, Kansas

STATE OF Kansas, COUNTY OF Butler, ss.  
L. C. Smitherman Drilling Company (employee of owner) or (owner or operator) of the above-described well, being first duly sworn on oath, says: That I have knowledge of the facts, statements, and matters herein contained and the log of the above-described well as filed and that the same are true and correct. So help me God. L. C. Smitherman

(Signature) [Signature]


P. O. Box 627, Augusta, Kansas  
(Address)

SUBSCRIBED AND SWORN TO before me this 11th day of February, 1955

Kath H. Carter

My commission expires October 23, 1958

Notary Public.

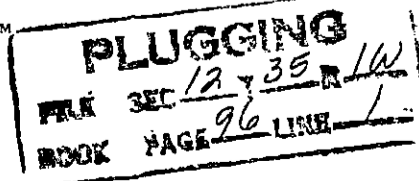

15-191-00229-0000

STRICKLAND #1

Company - A. W. Holiday  
 Contractor - L. C. Smitherman Drig. Co.  
 Commenced - 1-24-55  
 Completed - 2-6-55  
 Total Depth - 4033'  
 Initial Prod.

Location: SE SE SE, Sec. 12-35-1W,  
 Sumner County, Kansas  
 Elevation:  
 Casing: 8 5/8" - 3 1/2" Cemented w/250 Sls.

Figures Indicate Bottom of Formations:

Depth	Formation
0 - 220	Soil, Shale, Shells
220 - 305	Shale w/Lime Strips
305 - 342	Lime w/Shale Strips
342 - 360	Lime
360 - 500	Lime w/Shale Strips
500 - 680	Shale & Lime
680 - 720	Lime
720 - 980	Lime & Shale
980 - 1140	Shale w/Lime Strips
1140 - 1355	Lime & Shale
1355 - 1695	Lime & Shale & Shells
1695 - 1790	Shale w/Lime Strips
1790 - 1880	Lime & Shale
1880 - 2070	Lime
2070 - 2190	Lime & Shale
2190 - 2605	Shale, Lime & Sand
2605 - 2675	Shale & Lime
2675 - 2823	Sand
2823 - 2860	Sand & Shale
2860 - 2915	Shale, Lime & Sand
2915 - 3015	Shale & Lime
3015 - 3095	Shale & Shells
3095 - 3192	Sand
3192 - 3220	Shale & Sand
3220 - 3340	Shale & Lime
3340 - 3403	Lime
3403 - 3440	Shale, Lime & Sand
3440 - 3455	Shale & Lime
3455 - 3460	Lime & Shale
3460 - 3580	Lime
3580 - 3664	Lime & Shale
3664 - 3702	Shale & Lime
3702 - 3705	Shale
3705 - 3718	Chat
3718 - 3914	Lime
3914 - 4010	Shale
4010 - 4033	Sand
4033	Total Depth

We hereby certify the above and foregoing to be a true and correct copy of the Log on the Strickland #1, located in SE SE SE, Sec. 12-35-1W, Sumner County, Kansas.

L. C. SMITHERMAN DRILLING COMPANY  
*[Signature]*  
 L. C. Smitherman

Subscribed and sworn to before me this 9<sup>th</sup> day of February 1955.

\_\_\_\_\_  
 Notary Public

My commission expires October 23, 1958.

**PLUGGING**  
 PM SEC 12 35 R 1W  
 BOOK PAGE 96 LINE 1

RECEIVED  
 STATE OF KANSAS  
 FEB 11 1955  
 CONSERVATION DIVISION  
 Wichita, Kansas