


Give All Information Completely
Make Required Affidavit
Mail or Deliver Report to:
Conservation Division
State Corporation Commission
212 No. Market
Wichita, Kansas

WELL PLUGGING RECORD

Morton County, Sec. 20 Twp. 34S Rge. (E) 41 (W)

Location as "NE/CNW/SW" or footage from lines C SE SE
Lease Owner Blaik Oil Company
Lease Name Sharp Well No. 1
Office Address 203 Park Avenue, Oklahoma City, Oklahoma 73102
Character of Well (completed as Oil, Gas or Dry Hole) Dry Hole
Date well completed March 18 19 70
Application for plugging filed May 25 19 70
Application for plugging approved May 26 19 70
Plugging commenced June 16 19 70
Plugging completed June 16 19 70
Reason for abandonment of well or producing formation Dry Hole

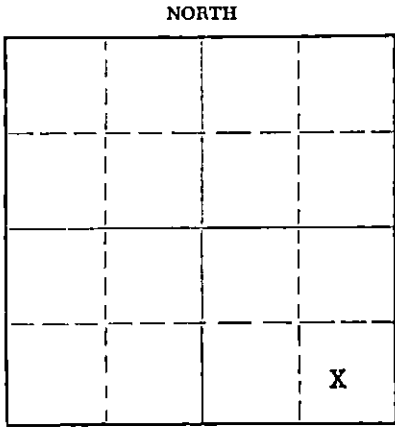

If a producing well is abandoned, date of last production _____ 19 ____
Was permission obtained from the Conservation Division or its agents before plugging was commenced? yes

Name of Conservation Agent who supervised plugging of this well Ed Eves, Sublet, Kansas
Producing formation _____ Depth to top _____ Bottom _____ Total Depth of Well 5548' Feet
Show depth and thickness of all water, oil and gas formations.

OIL, GAS OR WATER RECORDS

CASING RECORD

FORMATION	CONTENT	FROM	TO	SIZE	PUT-IN	PULLED OUT
				8-5/8	1439	None
				4-1/2	5547	3001'

Describe in detail the manner in which the well was plugged, indicating where the mud fluid was placed and the method or methods used in introducing it into the hole. If cement or other plugs were used, state the character of same and depth placed, from _____ feet to _____ feet for each plug set.

Pumped 1 bbl mud and 2 bbls. mud with 1 sack cotton seed hulls, 20 sks reg. cement, displace with 76 bbls. mud at 1000# pressure standing, top of plug 4700', shut in 1 hour and released it, put off a shot at 3500' could not pull pipe, came up hole to 3001' and put in charge, spotted 35 sks cement from 1000' to 900', pulled pipe, spotted 15 sks from 0-40', cut 8-5/8" Casing off 3' below surface, welded steel plate on top.

RECEIVED
STATE CORPORATION COMMISSION
JUN 18 1970
CONSERVATION DIVISION
Wichita, Kansas

(If additional description is necessary, use BACK of this sheet)
Name of Plugging Contractor Vi-Mar Engineering Company
Address P. O. Box 3263, Enid, Oklahoma 73701

STATE OF Oklahoma, COUNTY OF Oklahoma, ss.
Hilde Roberts (employee of owner) or (owner or operator) of the above-described well, being first duly sworn on oath, says: That I have knowledge of the facts, statements, and matters herein contained and the log of the above-described well as filed and that the same are true and correct. So help me God.

(Signature) Hilde Roberts
Hilde Roberts, Production Secretary

203 Park Avenue, Oklahoma City Oklahoma 73102

SUBSCRIBED AND SWORN to before me this 17 day of June, 19 70

Carolyn B. Chamberlain
Notary Public.

My commission expires 2/17/74