


WELL PLUGGING RECORD

Give All Information Completely
Make Required Affidavit
Mail or Deliver Report to:
Conservation Division
State Corporation Commission
211 No. Broadway
Wichita, Kansas

Morton County, Sec. 19 Twp. 34S Rge. 41W (E) (W)

Location as "NE/CNW&SW&" or footage from lines C SE NE
Lease Owner Anadarko Production Company
Lease Name Tucker Well No. 02
Office Address Box 351, Liberal, Kansas
Character of Well (completed as Oil, Gas or Dry Hole) Oil
Date well completed 9-30 19 57
Application for plugging filed 2-10 19 65
Application for plugging approved 2-11 19 65
Plugging commenced 3-11 19 65
Plugging completed 3-11 19 65
Reason for abandonment of well or producing formation Depleted

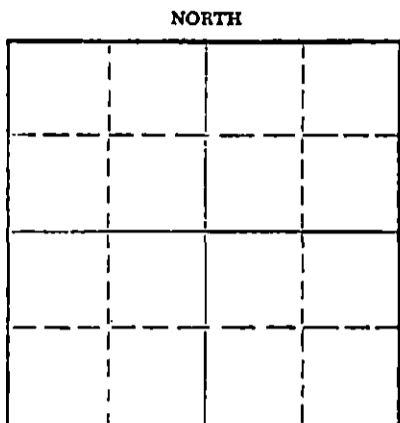

Locate well correctly on above
Section Plat

If a producing well is abandoned, date of last production January 19 65
Was permission obtained from the Conservation Division or its agents before plugging was commenced? Yes

Name of Conservation Agent who supervised plugging of this well Hugh Scott
Producing formation _____ Depth to top _____ Bottom _____ Total Depth of Well 5236 Feet
Show depth and thickness of all water, oil and gas formations.

OIL, GAS OR WATER RECORDS

CASING RECORD

FORMATION	CONTENT	FROM	TO	SIZE	PUT IN	PULLED OUT
				8-5/8"	1524'	
				5-1/2"	4800'	2636'

Describe in detail the manner in which the well was plugged, indicating where the mud fluid was placed and the method or methods used in introducing it into the hole. If cement or other plugs were used, state the character of same and depth placed, from _____ feet to _____ feet for each plug set.
Spotted 35 sxs. cement @ 4150', spotted 35 sxs. cement @ 700' and 15 sxs. @ 45'.

Handwritten notes and stamps:
MAD 17 1965
CORPORATION
WICHITA, KANSAS

(If additional description is necessary, use BACK of this sheet)
Name of Plugging Contractor Sargent's Casing Pulling Service
Address 1546 Clay Court, Liberal, Kansas

STATE OF KANSAS, COUNTY OF SEWARD, ss.
V. K. Downey, Supt. Drilling & Production (employee of owner) or (owner or operator) of the above-described well, being first duly sworn on oath, says: That I have knowledge of the facts, statements, and matters herein contained and the log of the above-described well as filed and that the same are true and correct. So help me God.

(Signature) V. K. Downey
Box 351, Liberal, Kansas
(Address)

SUBSCRIBED AND SWORN TO before me this 16th day of March 19 65
Donald L. Langston
Notary Public.

DRILLER'S LOG

WELL NAME: Tucker No. 02; COMPANY OPERATING: Anadarko Production Company
 ADDRESS of COMPANY: Box 351, Liberal, Kansas

WELL LOCATION: C 1/4 SE 1/4 NE 1/4,
3300 ft. North of South line,
4580 ft. East of West line; Sec. 19, Twp. 34S, Rge. 41W, Morton County, Kansas

DRILLING STARTED 8-17, 1957; DRILLING COMPLETED 9-13, 1957
 WELL COMPLETED 9-30, 1957; WELL CONNECTED _____, 19____

ELEVATION: 3454 ft. Ground Level; CHARACTER OF WELL (Oil, Gas, or Dry Hole) Oil

OIL OR GAS SANDS OR ZONES - PERFORATIONS - ACIDIZING AND FRACTURING INFORMATION					
Name	From	To	No. of Shots	Gallons Used	Kind Used
	4718	4721			

CASING RECORD

Size	Amount Set	Sacks of Cement	Amount Pulled

FORMATION RECORD

Formation	Top	Bottom	Formation	Top	Bottom
Sand & clay	0	150	Lime & shale	2615	4415
Shale, shells & red bed	150	445	Sand & shale	4415	4436
Red bed & shells	445	835	Lime & shale	4436	4441
Gyp	835	875	Lime	4441	4462
Shells & shale	875	950	Lime w/chert strks	4462	4510
Red bed, gyp & shells	950	1010	Lime & shale	4510	4697
Sand	1010	1175	Sand	4697	4735
Lime, red bed, gyp & shells	1175	1207	Shale & lime	4735	5052
Shale & shells	1207	1490	Sand	5052	5085
Red bed & shells	1490	1530	Sand & shale	5085	5118
Shale & shells	1530	2065	Lime & shale	5118	5147
Shale	2065	2335	Sand	5147	5167
Shale & shells	2335	2615	Lime	5167	5170

Lime w/chert strks & pyrite 5170 5236-T.D.

RESULTS of INITIAL PRODUCTION TEST: _____