


WELL PLUGGING RECORD

Give All Information Completely  
Make Required Affidavit  
Mail or Deliver Report to:  
Conservation Division  
State Corporation Commission  
212 No. Market  
Wichita, Kansas

Morton County, Sec. 9 Twp. 34S Rge. (E) 41 (W)  
Location as "NE/CNW%SW%" or footage from lines C SE NE

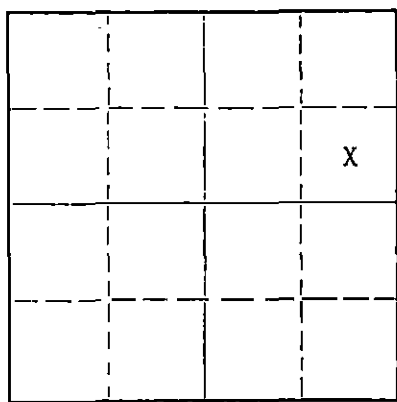

Locate well correctly on above  
Section Plat

Lease Owner Ran Ricks  
Lease Name Estelka Kreiger Well No. 1  
Office Address 425 Cravens Bldg., Oklahoma City, Okla.  
Character of Well (completed as Oil, Gas or Dry Hole) Dry Hole  
Date well completed June 8 19 72  
Application for plugging filed June 14 19 72  
Application for plugging approved June 8 19 72  
Plugging commenced June 8 19 72  
Plugging completed June 8 19 72  
Reason for abandonment of well or producing formation Dry

If a producing well is abandoned, date of last production 19  
Was permission obtained from the Conservation Division or its agents before plugging was commenced? Yes

Name of Conservation Agent who supervised plugging of this well Edgar J. Eves  
Producing formation \_\_\_\_\_ Depth to top \_\_\_\_\_ Bottom \_\_\_\_\_ Total Depth of Well 5630 Feet  
Show depth and thickness of all water, oil and gas formations.

OIL, GAS OR WATER RECORDS

CASING RECORD

FORMATION	CONTENT	FRDM	TD	SIZE	PUT IN	PULLED OUT
				8-5/8"	1492'	

Describe in detail the manner in which the well was plugged, indicating where the mud fluid was placed and the method or methods used in introducing it into the hole. If cement or other plugs were used, state the character of same and depth placed, from \_\_\_\_\_ feet to \_\_\_\_\_ feet for each plug set.

First Plug - 1100 - 950'  
Second Plug - 45 - 0'

RECEIVED  
STATE CORPORATION COMMISSION  
JUL 7 1972  
CONSERVATION DIVISION  
Wichita, Kansas  
7-7-72

(If additional description is necessary, use BACK of this sheet)

Name of Plugging Contractor Zenith Drilling Corporation, Inc.  
Address Suite 600 -200 W. Douglas, Wichita, Kansas 67202

STATE OF Kansas, COUNTY OF Sedgwick, ss.  
C. Robert Buford (employee of owner) of the above-described well, being first duly sworn on oath, says: That I have knowledge of the facts, statements, and matters herein contained and the log of the above-described well as filed and that the same are true and correct. So help me God.

(Signature) C. Robert Buford  
Suite 600-200 W. Douglas, Wichita, Ks. 67202  
(Address)

SUBSCRIBED AND SWORN TO before me this 15th day of June, 1972.

My commission expires August 15, 1975.  
Myrna S. Murphy Notary Public.

# WELL LOG

COMPANY Ran Ricks  
 FARM Estelka Kreiger NO. 1  
 TOTAL DEPTH 5630'  
 COMM. 5-27-72 COMP. 6-8-72  
 CONTRACTOR Zenith Drilling Corporation, Inc.

SEC. 9-34S-41W  
 LOC. C SE NE  
 COUNTY Morton

		X	

CASING

8-5/8" @ 1490 w/650 sx.

ELEVATION

PRODUCTION

FIGURES INDICATE BOTTOM OF FORMATIONS

- 1195' Surface Sand, Red Bed
- 1490' Sand, Anhydrite
- 1868' Red Bed
- 2160' Anhydrite, Red Bed
- 2380' Lime, Red Bed
- 3365' Lime, Shale
- 4335' Lime
- 4937' Lime, Shale
- 5223' Lime
- 5570' Shale, Lime
- 5630' Lime

RECEIVED  
 STATE CORPORATION COMMISSION  
 JUL 7 1972  
 CONSERVATION DIVISION  
 Wichita, Kansas

State of Kansas }  
 County of Sedgwick } ss

I, C. Robert Buford, President of Zenith Drilling Corporation, Inc.  
 upon oath state the above and foregoing is a true and correct copy of the log of the Estelka Kreiger #1 well.

Subscribed and sworn to before me this 15 day of June, 1972.

My Commission Expires: August 15, 1975.

C. Robert Buford  
Myrna D. Murphy  
 NOTARY PUBLIC