


STATE OF KANSAS  
STATE CORPORATION COMMISSION

Form CP-4

WELL PLUGGING RECORD

Give All Information Completely  
Make Required Affidavit  
Mail or Deliver Report to:  
Conservation Division  
State Corporation Commission  
211 No. Broadway  
Wichita, Kansas

NORTH

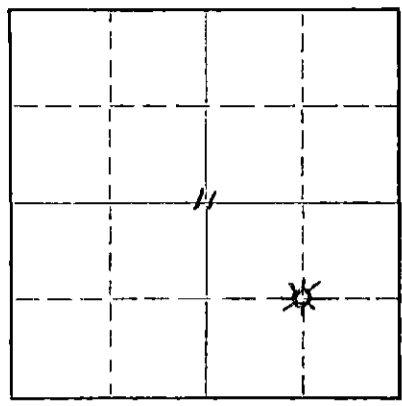

Locate well correctly on above  
Section Plat

Morton County, Sec. 11 Twp. 33S Rge. 10W (E) (W)  
Location as "NE/CNW/SW" or footage from lines C SE/4  
Lease Owner Mobil Oil Corporation  
Lease Name Burton Well No. 1  
Office Address P O Box 1934, OK City, OK. 73101  
Character of Well (completed as Oil, Gas or Dry Hole) Temporarily abandoned  
Date well completed Sept 23, 1953 19  
Application for plugging filed June, 1971 19  
Application for plugging approved June, 1971 19  
Plugging commenced July 1, 1971 19  
Plugging completed July 1, 1971 19  
Reason for abandonment of well or producing formation Production unsatisfactory.  
Acreage of this well attributed to a second well on this farm,  
If a producing well is abandoned, date of last production April, 1953 19  
Was permission obtained from the Conservation Division or its agents before plugging was commenced? Yes

Name of Conservation Agent who supervised plugging of this well E Eaves, Sublette, Kansas  
Producing formation Hugoton Series Depth to top 2401 Bottom 2601 Total Depth of Well 2620 Feet  
Show depth and thickness of all water, oil and gas formations.

OIL, GAS OR WATER RECORDS

CASING RECORD

FORMATION	CONTENT	FROM	TO	SIZE	PUT IN	PULLED OUT
				13 3/8 in	583 ft	None
				8 5/8 in	2410 ft	None
				7 in	219 ft	None

Describe in detail the manner in which the well was plugged, indicating where the mud fluid was placed and the method or methods used in introducing it into the hole. If cement or other plugs were used, state the character of same and depth placed, from See below feet to feet for each plug set.

See attachment. Ran 1 1/2 in tbg to 623 ft. Filled 8 5/8 in csg to top. (Mud at estimated 150 ft depth. Hole filled with fr water.) Csg standing full. Plug up from 623 ft with 35 sx Halliburton Common. Raised tubing to 60 ft. Circulated cement to surface. Csg standing full. Released J D Well Ser., Liberal, Kans, & Halliburton Cementers.

RECEIVED  
STATE CORPORATION COMMISSION  
AUG 30 1971  
CONSERVATION DIVISION  
Wichita, Kansas

(If additional description is necessary, use BACK of this sheet)

Name of Plugging Contractor See above. Mobil performed operations w/contract personnel & eqpmnt.  
Address J D Littrell, Mobil Oil Copr., P O Box 400, Hugoton, Kans. 67951

STATE OF Oklahoma, COUNTY OF Oklahoma, ss.  
Paul K. Langenberg (employee of owner) or (owner or operator) of the above-described well, being first duly sworn on oath, says: That I have knowledge of the facts, statements, and matters herein contained and the log of the above-described well as filed and that the same are true and correct. So help me God.

(Signature) Paul K. Langenberg  
Box 1934 Oklahoma City, Oklahoma (Address)

SUBSCRIBED AND SWORN TO before me this 27th day of August, 1971

My commission expires 11-17-73  
Richard N. Squibb Notary Public.