

STATE OF KANSAS
STATE CORPORATION COMMISSION

WELL PLUGGING RECORD


Give All Information Completely
Make Required Affidavit
Mail or Deliver Report to:
Conservation Division
State Corporation Commission
800 Bittling Building
Wichita, Kansas

Morton

County, Sec. 16 Twp. 33 Rge. (E) 40 (W)

Location as "NE/CNW&SW&" or footage from lines C SE NW
Lease Owner Musgrove Petroleum Corporation
Lease Name LOW Well No. 1
Office Address 518 Petroleum Building, Wichita, Kansas.
Character of Well (completed as Oil, Gas or Dry Hole) Dry
Date well completed April 11, 1955
Application for plugging filed verbally - April 14, 1955
Application for plugging approved verbally - April 14, 1955
Plugging commenced April 16, 1955
Plugging completed April 16, 1955
Reason for abandonment of well or producing formation

NORTH

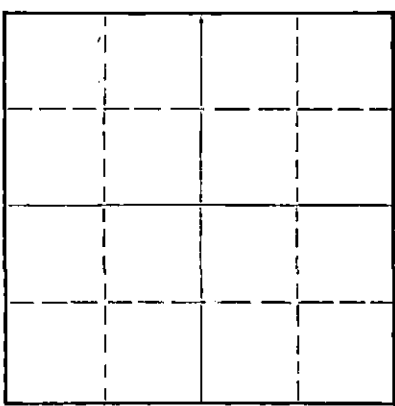

Locate well correctly on above
Section Flat

If a producing well is abandoned, date of last production 19
Was permission obtained from the Conservation Division or its agents before plugging was commenced? verbally - yes

Name of Conservation Agent who supervised plugging of this well M. A. Rives
Producing formation Depth to top Bottom Total Depth of Well 5800 Feet
Show depth and thickness of all water, oil and gas formations.

OIL, GAS OR WATER RECORDS

CASING RECORD

FORMATION	CONTENT	FROM	TO	SIZE	PUT IN	PULLED OUT
				13-5/8"	450'	
				8-5/8"	2505'	1193'

Describe in detail the manner in which the well was plugged, indicating where the mud fluid was placed and the method or methods used in introducing it into the hole. If cement or other plugs were used, state the character of same and depth placed, from feet to feet for each plug set.

Filled hole with mud to 450'.
Set 1st plug at 450' w/25 sx cement.
Filled hole w/mud to 40'.
Set 2nd plug at 40' w/20 sx cement.

(If additional description is necessary, use BACK of this sheet)

Name of Plugging Contractor Earl Miller
Address Great Bend, Kansas.

STATE OF Kansas COUNTY OF Sedgwick
I, Gordon L. Koelling, (employee of owner) or (owner or operator) of the above-described well, being first duly sworn on oath, says: That I have knowledge of the facts, statements, and matters herein contained and the log of the above-described well as filed and that the same are true and correct. So help me God.

(Signature) Gordon L. Koelling
518 Petroleum Building, Wichita, Kansas.
(Address)

SUBSCRIBED AND SWORN TO before me this 18th day of April, 1955

Notary Public

My commission expires September 24, 1955.

PLUGGING
FILE SEC 16 T 33 R 40W
BOOK PAGE 111 LINE 30

RECEIVED
STATE CORPORATION COMMISSION
APR 20 1955 4-20-55
CONSERVATION DIVISION
Wichita, Kansas

CONTRACTOR'S WELL LOG

COMPANY: Musgrove Petroleum Corporation
 CONTRACTOR: Musgrove Petroleum Corporation
 FARM: LOW #1
 LOCATION: C SE NW Sec. 16-33-40
 Morton County, Kansas
 COMMENCED: March 18, 1955
 COMPLETED: April 11, 1955

0	260	Sand & shells
260	400	Shale & shells
400	510	Red bed
510	730	Red bed & shale
730	1034	Shale & shells
1034	1090	Anhydrite
1090	1200	Sandy shale & shells
1200	1280	Sandy red shale
1280	1925	Shale & shells
1925	2340	Anhydrite & shale
2340	2507	Shale & shells
2507	2595	Sandy red shale & sandy lime
2595	3360	Lime & shale
3360	3451	Lime
3451	3585	Green shale & lime
3585	3650	Lime
3650	3735	Lime & shale
3735	3895	Lime
3895	4010	Lime & shale
4010	4045	Lime
4045	4245	Lime & shale
4245	4445	Lime
4445	5200	Lime & shale
5200	5480	Shale
5480	5738	Shale & lime
5738	5800	Lime
	5800	Rotary Total Depth

Set 13-5/8" surface pipe at 450' w/500 sacks cement, 2% calcium chloride
 Set 8-5/8" intermediate pipe at 2505' w/225 sx cement, 2% calcium chloride
 Dry and Abandoned

STATE OF KANSAS)
) SS
 COUNTY OF SEDGWICK)

I, GORDON L. KOELLING, do hereby certify that the above and foregoing is a true and correct copy of the log of the LOW #1, C SE NW, Section 16-33-40, Morton County, Kansas, as reflected by the files of the Musgrove Petroleum Corporation.

MUSGROVE PETROLEUM CORPORATION
 By *[Signature]*
 Secretary-Treasurer

Subscribed and sworn to before me, a Notary Public, in and for Sedgwick County, Kansas, this 14th day of April, 1955.

[Signature]
 Notary Public

My commission expires September 24, 1956.

PLUGGING
 SEC 16 T 33 R 40W
 PAGE 111 OF 150