


WELL PLUGGING RECORD

Give All Information Completely
Make Required Affidavit
Mail or Deliver Report to:
Conservation Division
State Corporation Commission
211 No. Broadway
Wichita, Kansas

Morton County, Sec. 17 Twp. 33S Rge. (E) 40 (W) C NE SW

NORTH

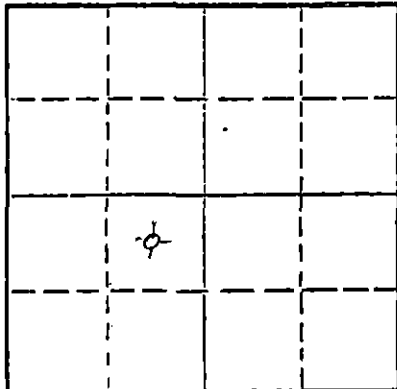

Locate well correctly on above Section Plat

Location as "NE/CNWXSWX" or footage from lines
Lease Owner Anadarko Production Company
Lease Name Low "C" Well No. 3
Office Address Box 351 Liberal, Kansas
Character of Well (completed as Oil, Gas or Dry Hole) Dry Hole
Date well completed 11-24 19 65
Application for plugging filed 11-26 19 65
Application for plugging approved 11-23 19 65
Plugging commenced 11-24 19 65
Plugging completed 11-24 19 65
Reason for abandonment of well or producing formation Dry Hole

If a producing well is abandoned, date of last production 19
Was permission obtained from the Conservation Division or its agents before plugging was commenced? Yes

Name of Conservation Agent who supervised plugging of this well Hugh E. Scott
Producing formation None Depth to top Bottom Total Depth of Well 5830 Feet
Show depth and thickness of all water, oil and gas formations.

OIL, GAS OR WATER RECORDS

CASING RECORD

| FORMATION | CONTENT | FROM | TO | SIZE | PUT IN | PULLED OUT |
|-----------|---------|------|----|-------|--------|------------|
| None | | | | 8-5/8 | 1496' | |
| | | | | | | |
| | | | | | | |
| | | | | | | |
| | | | | | | |
| | | | | | | |
| | | | | | | |
| | | | | | | |
| | | | | | | |

Describe in detail the manner in which the well was plugged, indicating where the mud fluid was placed and the method or methods used in introducing it into the hole. If cement or other plugs were used, state the character of same and depth placed, from feet to feet for each plug set.

Spotted 35 sacks cement @ 700'
Filled hole with mud to 45'
Spotted 15 sacks cement 45' to surface.
Completed 5 am 11-24-65.

RECEIVED
STATE CORPORATION COMMISSION

DEC -2 1965

Wichita, Kansas

(If additional description is necessary, use BACK of this sheet)

Name of Plugging Contractor Holm Drilling Company
Address P. O. Box 7505, Tulsa, Oklahoma

STATE OF Kansas COUNTY OF Seward ss.
V. K. Downey (employee of owner) or (owner or operator) of the above-described

well, being first duly sworn on oath, says: That I have knowledge of the facts, statements, and matters herein contained and the log of the above-described well as filed and that the same are true and correct. So help me God.

(Signature) V. K. Downey
Box 351 Liberal, Kansas
(Address)

SUBSCRIBED AND SWORN TO before me this 29 day of November, 19 65

Ronald L. Vanjason
Notary Public.

My commission expires My Commission Expires Sept. 29, 1968

DRILLER'S LOG

WELL NAME: Low "C" No. 3 ; COMPANY OPERATING: Anadarko Production Company
 ADDRESS of COMPANY: Box 351 Liberal, Kansas

WELL LOCATION: C 1/4 NE 1/4 SW 1/4,
1980 ft. North of South line,
1980 ft. East of West line; Sec. 17, Twp. 33S, Rge. 40W, Morton County, Kansas

DRILLING STARTED 11-6, 1965; DRILLING COMPLETED 11-24, 1965
 WELL COMPLETED _____, 19____; WELL CONNECTED _____, 19____

ELEVATION: 3260.9 ft. Ground Level; CHARACTER OF WELL (Oil, Gas, or Dry Hole) Dry Hole

| OIL OR GAS SANDS OR ZONES - PERFORATIONS - ACIDIZING AND FRACTURING INFORMATION | | | | | |
|---|------|----|--------------|--------------|-----------|
| Name | From | To | No. of Shots | Gallons Used | Kind Used |
| | | | | | |
| | | | | | |
CASING RECORD

| Size | Amount Set | Sacks of Cement | Amount Pulled |
|-------|------------|-----------------|---------------|
| 8-5/8 | 1496' | 750 | |
| | | | |
| | | | |
| | | | |

FORMATION RECORD

| Formation | Top | Bottom | Formation | Top | Bottom |
|---------------------|------|--------|-------------|-----|--------|
| Sand | 0 | 180 | TOTAL DEPTH | | 5830 |
| Sand & Clay | 180 | 220 | | | |
| Surface Sand & Clay | 220 | 395 | | | |
| Red Bed & Shells | 395 | 570 | | | |
| Shale & Gyp | 570 | 975 | | | |
| Gyp | 975 | 1205 | | | |
| Shale & Shells | 1205 | 1490 | | | |
| Anhy | 1490 | 1550 | | | |
| Shale & Shells | 1550 | 2555 | | | |
| Shale & Lime | 2555 | 2705 | | | |
| Lime | 2705 | 4685 | | | |
| Lime & Shale | 4685 | 5580 | | | |
| Lime | 5580 | 5830 | | | |

RESULTS of INITIAL PRODUCTION TEST: _____