

R

STATE OF KANSAS  
STATE CORPORATION COMMISSION

Form CP-4


Give All Information Completely  
Make Required Affidavit  
Mail or Deliver Report to:  
Conservation Division  
State Corporation Commission  
211 No. Broadway  
Wichita, Kansas

WELL PLUGGING RECORD

Morton County, Sec. 19 Twp. 33 Rge. (E) 40 (W)

Location as "NE/CNW/SW" or footage from lines C SW NE  
Lease Owner Anadarko Production Company  
Lease Name Conard "A" Well No. 2  
Office Address Box 351 Liberal, Kansas  
Character of Well (completed as Oil, Gas or Dry Hole) Dry Hole  
Date well completed August 31 1965  
Application for plugging filed August 31 1965  
Application for plugging approved August 31 1965  
Plugging commenced August 31 1965  
Plugging completed August 31 1965  
Reason for abandonment of well or producing formation Dry Hole

NORTH

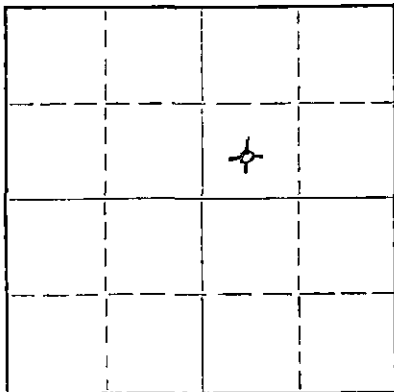

Locate well correctly on above  
Section Plat

If a producing well is abandoned, date of last production None 19  
Was permission obtained from the Conservation Division or its agents before plugging was commenced? Yes

Name of Conservation Agent who supervised plugging of this well Hugh Scott Sublette, Kansas  
Producing formation None Depth to top - Bottom - Total Depth of Well 5844 Feet  
Show depth and thickness of all water, oil and gas formations.

OIL, GAS OR WATER RECORDS

CASING RECORD

FORMATION	CONTENT	FROM	TO	SIZE	PUT IN	PULLED OUT
None				8 5/8	1496	None

Describe in detail the manner in which the well was plugged, indicating where the mud fluid was placed and the method or methods used in introducing it into the hole. If cement or other plugs were used, state the character of same and depth placed, from \_\_\_\_\_ feet to \_\_\_\_\_ feet for each plug set.

Spotted 20 sxs Cement @ 5830' filled with mud to 5530'  
Spotted 20 sxs Cement @ 5530' filled with mud to 700'  
Spotted 35 sxs Cement @ 700' filled with mud to 45'  
Spotted 20 sxs Cement from 45' to surface  
Completed 7:00 A.M. August 31, 1965

RECEIVED  
STATE CORPORATION COMMISSION

SEP 14 1965

CONSERVATION DIVISION  
Wichita, Kansas

(If additional description is necessary, use BACK of this sheet)

Name of Plugging Contractor Holm Drilling Company  
Address P. O. Box 7505 Southside Station Tulsa 9, Oklahoma

STATE OF Kansas, COUNTY OF Seward, ss.  
V. K. Downey (employee of owner) or (owner or operator) of the above-described well, being first duly sworn on oath, says: That I have knowledge of the facts, statements, and matters herein contained and the log of the above-described well as filed and that the same are true and correct. So help me God.

(Signature) V. K. Downey  
Division Supt. Drilling and Production  
Box 351 Liberal, Kansas  
(Address)

SUBSCRIBED AND SWORN TO before me this 3rd day of September, 1965

Donald L. Ferguson  
Notary Public.

My commission expires \_\_\_\_\_  
My Commission Expires Sept. 29, 1968

DRILLER'S LOG

19-33-40W

WELL NAME: Conard "A" No. 2 ; COMPANY OPERATING: Anadarko Production Company  
 ADDRESS of COMPANY: Box 351 Liberal, Kansas

WELL LOCATION: C 1/4 SW 1/4 NE 1/4,  
3300 ft. North of South line,  
3300 ft. East of West line; Sec. 19, Twp. 33S, Rge. 40W, Morton County, Kansas

DRILLING STARTED August 12, 1965; DRILLING COMPLETED August 31, 1965  
 WELL COMPLETED August 31, 1965; WELL CONNECTED -, 19-

ELEVATION: 3282.9 ft. Ground Level; CHARACTER OF WELL (Oil, Gas, or Dry Hole) Dry

OIL OR GAS SANDS OR ZONES - PERFORATIONS - ACIDIZING AND FRACTURING INFORMATION					
Name	From	To	No. of Shots	Gallons Used	Kind Used
None	None	None	None	None	None

RECEIVED  
 STATE CORPORATION COMMISSION  
 SEP 14 1965  
 CONSERVATION DIVISION  
 WICHITA, KANSAS

CASING RECORD

Size	Amount Set	Sacks of Cement	Amount Pulled
8-5/8	1496'	750 sxs	None

FORMATION RECORD

Formation	Top	Bottom	Formation	Top	Bottom
Sand & Clay	0	350	Lime	3840	4345
Shale & Shell - Gyp	350	430	Lime & Shale	4345	4460
Red Bed & Shells	430	475	Lime	4460	4840
Shale & Gyp	475	960	Lime & Shale	4840	5280
Gyp	960	1045	Shale	5280	5383
Sand	1045	1235	Sandy Shale	5383	5400
Shale & Shell	1235	1487	Shale & Lime - Sand	5400	5567
Anhy	1487	1497	Lime & Shale	5567	5655
Shale & Shell	1497	1710	Lime	5655	5844
Shale	1710	2575			
Shale & Lime	2575	3485	TOTAL DEPTH		5844
Lime	3485	3615			
Lime with Shale	3615	3840			

RESULTS of INITIAL PRODUCTION TEST: None