


STATE OF KANSAS  
STATE CORPORATION COMMISSION

Form CP-4

WELL PLUGGING RECORD

Give All Information Completely  
Make Required Affidavit  
Mail or Deliver Report to:  
Conservation Division  
State Corporation Commission  
212 No. Market  
Wichita, Kansas 67202

NORTH

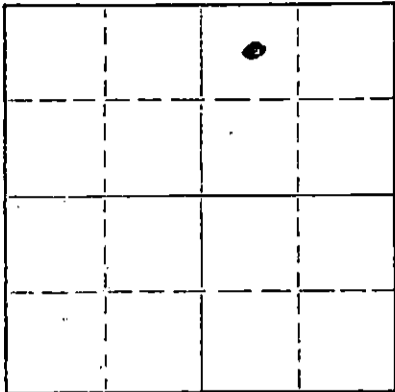

Locate well correctly on above  
Section Plat

Meade County. Sec. 20 Twp. 34S Rge. 30W (E) (W)  
Location as "NE/CNW/SW" or footage from lines. C NW/4 of NE/4  
Lease Owner Allen & Parker  
Lease Name Adams Well No. 1  
Office Address Box 906, Perryton, Texas 79070  
Character of Well (completed as Oil, Gas or Dry Hole) Gas  
Date well completed 3-9-70 19\_\_  
Application for plugging filed 9-2-71 19\_\_  
Application for plugging approved 19\_\_  
Plugging commenced 9-15-71 19\_\_  
Plugging completed 9-15-71 19\_\_  
Reason for abandonment of well or producing formation Depleted

If a producing well is abandoned, date of last production Nov 19 70  
Was permission obtained from the Conservation Division or its agents before plugging was commenced? Yes

Name of Conservation Agent who supervised plugging of this well Edgar Eves - Sublette, Kansas  
Producing formation Morrow Depth to top 5923 Bottom 5930 Total Depth of Well 5987 Feet  
Show depth and thickness of all water, oil and gas formations.

OIL, GAS OR WATER RECORDS

CASING RECORD

FORMATION	CONTENT	FROM	TO	SIZE	PUT IN	PULLED OUT
Permo-Penn Carbonates	Salt water	2665	3748	3/4"		2723
Toronto	" "	4470	4485			
Lansing-Kansas City	" "	4590	5270			
Marmaton	" "	5270	5470			
Lower Morrow	Gas & Salt Water	5923	5930			

Describe in detail the manner in which the well was plugged, indicating where the mud fluid was placed and the method or methods used in introducing it into the hole. If cement or other plugs were used, state the character of same and depth placed, from 5796 feet to \_\_\_\_\_ feet for each plug set.

Pumped 15 sxs cement followed by rubber plug to 5796. Pumped plug down with 40 vis. 9.5# mud.  
Shot pipe off @ 2723'. Pulled out of hole to 1287' and pumped 35 sxs cement and displaced with 40 vis. 9.5# mud.  
Pulled pipe out of hole. Mixed and dumped 15 sxs cement in top of hole. Cut 8 5/8" pipe off 13' below ground level and welded on cap.

RECEIVED  
STATE CORPORATION COMMISSION  
OCT 4 1971  
CONSERVATION DIVISION  
Wichita, Kansas

(If additional description is necessary, use BACK of this sheet)  
Name of Plugging Contractor Perryton Service Co.  
Address Box 906, Perryton, Texas 79070

STATE OF Texas, COUNTY OF Ochiltree, SS.  
Bill Hair (employee of owner) or (owner or operator) of the above-described well, being first duly sworn on oath, says: That I have knowledge of the facts, statements, and matters herein contained and the log of the above-described well as filed and that the same are true and correct. So help me God.

(Signature) Bill Hair

(Address)

SUBSCRIBED AND SWORN TO before me this 1st day of October, 19 71

Leah J. Miller

My commission expires June 1, 1973

Notary Public.