


STATE OF KANSAS
STATE CORPORATION COMMISSION

Give All Information Completely
Make Required Affidavit
Mail or Deliver Report to:
Conservation Division
State Corporation Commission
800 Biting Building
Wichita, Kansas

WELL PLUGGING RECORD

NORTH

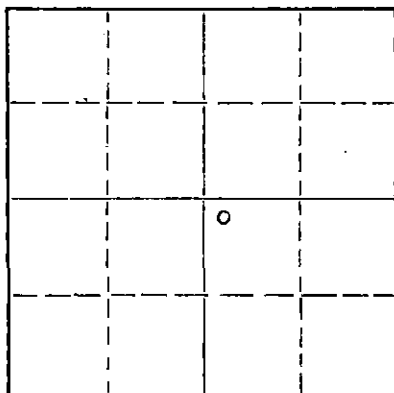

Locate well correctly on above
Section Plat

MEADE County. Sec. 20 Twp. 32S Rge. 30 (E) (W)
Location as "NE/CNWKSWK" or footage from lines 2310' from South and East
Lease Owner The Shamrock Oil and Gas Corporation
Lease Name H. C. Bender Well No. 1
Office Address Box 631, Amarillo, Texas
Character of Well (completed as Oil, Gas or Dry Hole) Dry Hole
Date well completed December 7, 1956
Application for plugging filed December 7, 1956
Application for plugging approved December 7, 1956
Plugging commenced December 7, 1956
Plugging completed December 7, 1956
Reason for abandonment of well or producing formation Dry

If a producing well is abandoned, date of last production None 19
Was permission obtained from the Conservation Division or its agents before plugging was commenced? Yes

Name of Conservation Agent who supervised plugging of this well Merle Rives
Producing formation None Depth to top --- Bottom --- Total Depth of Well 5732' Feet
Show depth and thickness of all water, oil and gas formations.

OIL, GAS OR WATER RECORDS

CASING RECORD

FORMATION	CONTENT	FROM	TO	SIZE	PUT IN	PULLED OUT
Sand and shale	Water	70	600	9 5/8"	2726.92	-0-

Describe in detail the manner in which the well was plugged, indicating where the mud fluid was placed and the method or methods used in introducing it into the hole. If cement or other plugs were used, state the character of same and depth placed, from _____ feet to _____ feet for each plug set.
Pushed 9 5/8" OD Halliburton plug to 730'. Spotted 35 sacks of cement from 730' to 642'. Filled casing with mud. Pushed 9 5/8" OD Halliburton plug to 30'. Filled casing from 30' to 0' with 15 sacks cement.

(If additional description is necessary, use BACK of this sheet)
Name of Plugging Contractor Halliburton Oil Well Cementing Company
Address Great Bend, Kansas

STATE OF TEXAS COUNTY OF POTTER, ss.
T. S. Clopton (employee of owner) or (owner/operator) of the above-described well, being first duly sworn on oath, says: That I have knowledge of the facts, statements, and matters herein contained and the log of the above-described well as filed and that the same are true and correct. So help me God.

(Signature) T. S. Clopton

Box 631, Amarillo, Texas (Address)

SUBSCRIBED AND SWORN TO before me this 10th day of December, 1956

PAULINE POWELL
Notary Public
Pötter County, Texas
Notary Public.

My commission expires 6-1-57

PLUGGING
FILE SEC 20 T. 32 R. 30 W.
BOOK PAGE 123 LI E. 40

H. C. BENDER

Section 20, Township 32 South, Range 30 West
Meade County, Kansas

0 - 70	Surface soil and sandy shale
70 - 580	Sand and shale
580 - 875	Red bed and shells
875 - 940	Lime and shale
940 - 1,625	Shale and shells
1,625 - 1,660	Chalky lime
1,660 - 1,825	Shale
1,825 - 2,355	Sand, shale, and lime
2,355 - 2,600	Anhydrite and shale
2,600 - 2,660	Anhydrite
2,660 - 2,725	Anhydrite and dolomite streaks
2,725 - 3,000	Dolomite
3,000 - 3,890	Lime
3,890 - 3,940	Shale
3,940 - 3,990	Limey shale
3,990 - 4,040	Shale
4,040 - 4,150	Lime
4,150 - 4,240	Limey shale
4,240 - 4,320	Shale
4,320 - 4,380	Lime
4,380 - 4,420	Black shale
4,420 - 4,450	Lime
4,450 - 4,520	Shale
4,520 - 4,560	Shaley lime
4,560 - 4,740	Lime
4,740 - 4,820	Shaley lime
4,820 - 4,910	Lime
4,910 - 4,970	Shale
4,970 - 5,010	Lime
5,010 - 5,080	Shale
5,080 - 5,240	Lime with shale streaks
5,240 - 5,325	Shale with lime streaks
5,325 - 5,560	Shale and lime streaks
5,560 - 5,570	Shale
5,570 - 5,580	Limey sand
5,580 - 5,620	Shale
5,620 - 5,660	Lime
5,660 - 5,732	Shale with scattered lime streaks.

PLUGGING
FILE SEC 20 T 32 R 30W
BOOK PAGE 123 LINE 40

RECEIVED
STATE OF KANSAS
DEC 12 1915
CONSERVATION DIVISION
Wichita, Kansas