


STATE OF KANSAS
STATE CORPORATION COMMISSION

WELL PLUGGING RECORD

Give All Information Completely
Make Required Affidavit
Must be or Deliver Report to:
Conservation Division
State Corporation Commission
211 No. Broadway
Wichita, Kansas

Meade County, Sec. 21 Twp. 32S Rge. 30W (E) (W)
Location as "NE/CNW/SW" or footage from lines 660' fr. E & 1320' fr S lines
Lease Owner Horizon Oil & Gas Co.
Lease Name Collingwood Well No. 1-21
Office Address P.O. Box 7, Spearman, Texas 79081
Character of Well (completed as Oil, Gas or Dry Hole) Dry hole
Date well completed March 8 19 66
Application for plugging filed April 13 19 66
Application for plugging approved April 15 19 66
Plugging commenced April 25 19 66
Plugging completed April 25 19 66
Reason for abandonment of well or producing formation Dry hole

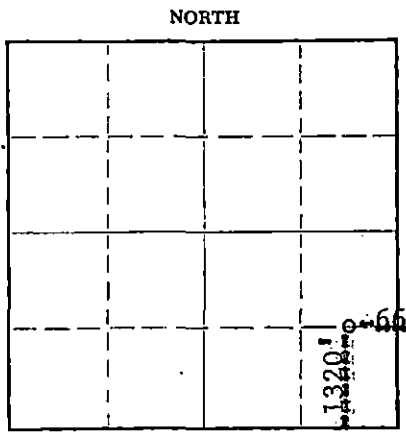

Locate well correctly on above
Section Plat

If a producing well is abandoned, date of last production None 19
Was permission obtained from the Conservation Division or its agents before plugging was commenced? Yes

Name of Conservation Agent who supervised plugging of this well Edgar J. Eves
Producing formation none Depth to top Bottom Total Depth of Well 6065 Feet
Show depth and thickness of all water, oil and gas formations.

OIL, GAS OR WATER RECORDS

CASING RECORD

FORMATION	CONTENT	FROM	TO	SIZE	PUT IN	PULLED OUT
	Water	5900'	6065'	8-5/8"	1428	NONE
				4-1/2"	6060	3015'

Describe in detail the manner in which the well was plugged, indicating where the mud fluid was placed and the method or methods used in introducing it into the hole. If cement or other plugs were used, state the character of same and depth placed, from feet to feet for each plug set.

Set 20 sack plug @ 5780'.
Set 35 sack cement plug @ 604' to 704'
Set 15 sack plug @ 4' to 50'
Welded on cap.

RECEIVED
STATE CORPORATION COMMISSION

APR 29 1966

CONSERVATION DIVISION
Wichita, Kansas

(If additional description is necessary, use BACK of this sheet)

Name of Plugging Contractor Daco Lease & Well Service
Address 1700 S. Main Street, Borger, Texas

STATE OF Texas, COUNTY OF Hansford, ss.
Everett R. Tracy (employee of owner) of the above-described well, being first duly sworn on oath, says: That I have knowledge of the facts, statements, and matters herein contained and the log of the above-described well as filed and that the same are true and correct. So help me God.

(Signature) *Everett R. Tracy*
P.O. Box 7, Spearman, Texas 79081
(Address)

SUBSCRIBED AND SWORN TO before me this 28th day of April, 1966

My commission expires June 1, 1966
Jessie Garcia
Hansford County, Texas Notary Public.



15-119-10094-0000

MORAN BROS., INC.

OIL & GAS BUILDING
WICHITA FALLS, TEXAS

HORIZON OIL & GAS CO.
Collingwood No. 1-21
Driller's Log
Section 21, Township 32S, Range 30W
Meade County, Kansas

<u>Formation</u>	<u>From</u>	<u>To</u>
Clay and sand	0	502
Redbed and Anhydrite	502	2355
Shale and Anhydrite	2355	2610
Lime and shale	2610	3050
Lime and chalk	3050	3115
Chalky lime	3115	3390
Lime and chalk	3390	3840
Lime and shale	3840	4400
Lime	4400	5169
Lime and sand	5169	5203
Lime	5203	5320
Lime and sand	5320	5410
Lime	5410	5535
Lime and shale strks.	5535	5645
Lime and shale	5645	5926
Lime	5926	6004
Lime, shale, sandy lime	6004	6015
Sand and lime	6015	6051
Lime	6051	6065

TOTAL DEPTH

6065 SLM.

RECEIVED
STATE CORPORATION COMMISSION

JUN 20 1966
Deemed true and correct.

MORAN BROS., INC
CONSERVATION DIVISION
Wichita, Kansas
By *T. E. Swift*
T. E. Swift



RECEIVED
MAR 23 1963
HORIZON OIL AND GAS CO.
SPEARMAN, TEXAS