

STATE OF KANSAS
STATE CORPORATION COMMISSION


Give All Information Completely
Make Required Affidavit
Mail or Deliver Report to:
Conservation Division
State Corporation Commission
211 No. Broadway
Wichita, Kansas

WELL PLUGGING RECORD

Meade County, Sec. 23 Twp. 32 Rge. (E) 30 (W)

Location as "NE/CNW/SW" or footage from lines. C NW NW
Lease Owner Colorado Oil & Gas Corporation
Lease Name Bisbee Well No. 1
Office Address Box 999, Liberal, Kansas
Character of Well (completed as Oil, Gas or Dry Hole) Dry Hole
Date well completed 1-25-62 19
Application for plugging filed yes 19
Application for plugging approved yes 19
Plugging commenced 6 P.M. 1-25-62 19
Plugging completed 2 A.M. 1-26-62 19
Reason for abandonment of well or producing formation No Production

NORTH

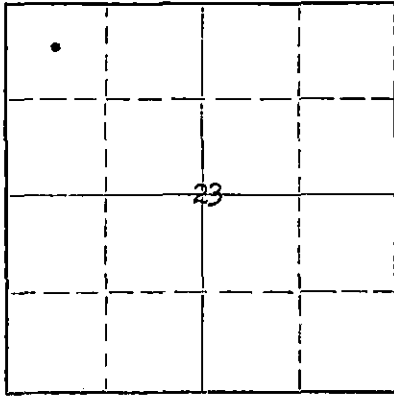

Locate well correctly on above
Section Plat

If a producing well is abandoned, date of last production 19
Was permission obtained from the Conservation Division or its agents before plugging was commenced? yes

Name of Conservation Agent who supervised plugging of this well W. L. LeKamp Jr.
Producing formation None Depth to top Bottom Total Depth of Well 6140 Feet KB
Show depth and thickness of all water, oil and gas formations.

OIL, GAS OR WATER RECORDS

CASING RECORD

FORMATION	CONTENT	FROM	TO	SIZE	PUT IN	PULLED OUT
Permian	Water	238	490	9 5/8"	1615	none

Describe in detail the manner in which the well was plugged, indicating where the mud fluid was placed and the method or methods used in introducing it into the hole. If cement or other plugs were used, state the character of same and depth placed, from feet to feet for each plug set.

Filled hole with heavy mud. Set plug at 1600' with 20 sacks cement on top to 1550'. Filled hole with mud to 600' ran 20 sacks cement on top wooden plug, filled hole with heavy mud to 35', set wooden plug & cemented to three feet below ground surface.

RECEIVED
STATE CORPORATION COMMISSION
JAN 30 1962
CONSERVATION DIVISION
Wichita, Kansas

(If additional description is necessary, use BACK of this sheet)

Name of Plugging Contractor Patton Drilling Company, Inc.
Address Orpheum Building, Wichita, Kansas

STATE OF Kansas, COUNTY OF Seward, ss.
J. A. Ziser (employee of owner) or (owner or operator) of the above-described well, being first duly sworn on oath, says: That I have knowledge of the facts, statements, and matters herein contained and the log of the above-described well as filed and that the same are true and correct. So help me God.

(Signature) *J. A. Ziser*
(Address)

SUBSCRIBED AND SWORN TO before me this 26 day of January, 1962

William B. Claunch
Notary Public.

My commission expires 11-1-62

