

15-173-00480-0000


STATE OF KANSAS
STATE CORPORATION COMMISSION

WELL PLUGGING RECORD

Give All Information Completely
Make Required Affidavit
Mail or Deliver Report to:
Conservation Division
State Corporation Commission
800 Bitting Building
Wichita, Kansas

Sedgwick County, Sec. 24 Twp. 29 Rge. 2 (E) (W)
Location as "NE/CNW/SW" or footage from lines NE NE NW
Lease Owner Shawver-Armour, Inc.
Lease Name Chambers Well No. 1
Office Address 817 Central Building
Character of Well (completed as Oil, Gas or Dry Hole) Dry Hole
Date well completed 11-27-55 19
Application for plugging filed 11-27-55 19
Application for plugging approved 11-27-55 19
Plugging commenced 11-27-55 19
Plugging completed 11-27-55 19
Reason for abandonment of well or producing formation Dry Hole

NORTH

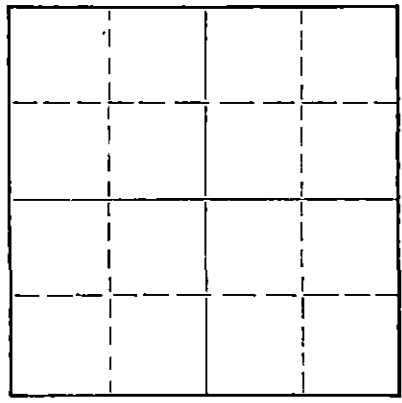

Locate well correctly on above
Section Plat

If a producing well is abandoned, date of last production None 19
Was permission obtained from the Conservation Division or its agents before plugging was commenced? Yes

Name of Conservation Agent who supervised plugging of this well _____
Producing formation Mississippian Depth to top 3603 Bottom 3653 Total Depth of Well 3653 Feet
Show depth and thickness of all water, oil and gas formations.

OIL, GAS OR WATER RECORDS

CASING RECORD

FORMATION	CONTENT	FROM	TO	SIZE	PUT IN	PULLED OUT
Surface	Water	0	365	8-5/8	365	None

Describe in detail the manner in which the well was plugged, indicating where the mud fluid was placed and the method or methods used in introducing it into the hole. If cement or other plugs were used, state the character of same and depth placed, from _____ feet to _____ feet for each plug set.

3659-250' Fill w/ heavy mud
250' Good Permanent Plug and 15 sxs cement run through drill pipe.
20' Good Permanent plug and 5 sxs cement to bottom of cellar.

(If additional description is necessary, use BACK of this sheet)

Name of Plugging Contractor Shawver-Armour, Inc.
Address 817 Central Building, Wichita, Kansas

STATE OF Kansas, COUNTY OF Sedgwick, ss.
James Armour (employee of owner) or (owner or operator) of the above-described well, being first duly sworn on oath, says: That I have knowledge of the facts, statements, and matters herein contained and the log of the above-described well as filed and that the same are true and correct. So help me God.

(Signature) James Armour
817 Central Building (Address)

SUBSCRIBED AND SWORN TO before me this 29th day of November, 19 55

Rosemary Penrose
Rosemary Penrose Notary Public.

My commission expires March 30, 1957

PLUGGING
FILE SEC 24 T. 29 R. 2W
BOOK PAGE 32 LINE 9

12-1-55
Wichita, Kansas

DRILLING LOG

COMPANY: SHAWVER-ARMOUR INC. LOCATION: NE NE 1/4
 CONTRACTOR: SHAWVER-ARMOUR INC. Sec. 24-29-2W
 Sedwick County
 FIELD NAME: CHAMBERS #1 ELEVATION: 1291 FT
 COMMENCED: November 16, 1955
 COMPLETED: November 27, 1955

CASING RECORD

365' 8-5/8" w/225 sq cas.

FORMATION	FROM	TO	
Surface Clay & Shale	0	70	
Shale w/Lime Strk & Salt		345	
Anhydrite		365	TOPS
Anhydrite & Shale		425	
Lime		490	Kansas City 2965
Salt & Shale		520	Mississippi Line 3603
Shale & Lime		980	RFD 3653
Lime		1025	
Shale & Lime Strk		1610	
Lime & Shale		1625	
Shale w/Lime Strk		1960	
Lime & Shale		2285	
Lime w/shale Strk		2425	
Shale w/Lime Shells		2585	
Shale & Lime		2687	
Sand & Shale		2755	
Sandy Shale		2787	
Lime & Shale		2860	
Shale & Lime		2923	
Shale		2965	
K.C. Lime		3034	
Lime		3175	
Lime & Shale		3354	
Shale & Lime		3430	
Lime & Shale		3570	
Shale & Lime		3608	
Lime		3653 RFD	

STATE OF KANSAS)
) ss
 SEDWICK COUNTY)

I, James Armour, do hereby certify that the above is a true and correct copy of the log on the above captioned well, as shown on the daily drilling reports.

SHAWVER-ARMOUR, INC.
 By James Armour
 James Armour, Sec. Treas.

Subscribed and sworn to before me this
 30th day of November 1955

Rosemary Penrose
 Rosemary Penrose, Notary Public

My commission expires March 30, 1957.

PLUGGING
 FILE SEC 24 T 29 R 2W
 30
 BOOK PAGE 27 LINE 9

RECEIVED
 STATE OF KANSAS
 DEPT. OF REVENUE
 NOV 1 1955
 DIVISION