


STATE OF KANSAS
STATE CORPORATION COMMISSION

Give All Information Completely
Make Required Affidavit
Mail or Deliver Report to:
Conservation Division
State Corporation Commission
212 North Market, Insurance Bldg.
Wichita, Kansas

WELL PLUGGING RECORD

NORTH

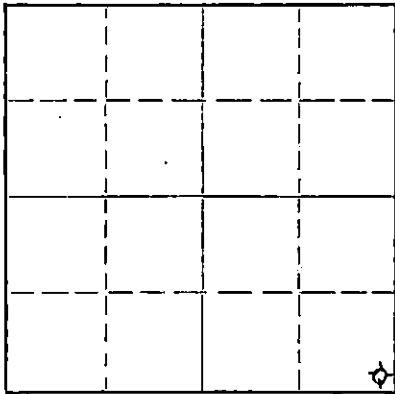

Locate well correctly on above
Section Flat

Sedgwick County. Sec. 22 Twp. 29S Rge. 2W (E) (W)
Location as "NE/CNW/SW" or footage from lines SE SE SE
Lease Owner Diversified Oil Investments, Inc.
Lease Name Tjaden Well No. A-1
Office Address 201 Mobil Building Wichita, Kansas
Character of Well (completed as Oil, Gas or Dry Hole) Dry Hole
Date well completed November 21, 1959
Application for plugging filed November 21, 1959
Application for plugging approved November 21, 1959
Plugging commenced November 21, 1959
Plugging completed November 21, 1959
Reason for abandonment of well or producing formation Failed to find commercial shows of oil or gas.
If a producing well is abandoned, date of last production 19
Was permission obtained from the Conservation Division or its agents before plugging was commenced? Yes.

Name of Conservation Agent who supervised plugging of this well O. D. Garrett
Producing formation Depth to top Bottom Total Depth of Well 3040' Feet
Show depth and thickness of all water, oil and gas formations.

OIL, GAS OR WATER RECORDS

CASING RECORD

FORMATION	CONTENT	FROM	TO	SIZE	PUT IN	PULLED OUT
				8 5/8"	384'	Cemented.

Describe in detail the manner in which the well was plugged, indicating where the mud fluid was placed and the method or methods used in introducing it into the hole. If cement or other plugs were used, state the character of same and depth placed, from feet to feet for each plug set.

Filled hole with heavy rotary mud to 250'. Set HDWOO plug at 250'. Spotted 25 sacks cement on plug. Filled hole with rotary mud to 40'. Set HDWOO plug at 40' feet. Spotted 10 sacks cement on plug. Cut off surface pipe 36" below ground level. Bridged rat hole with 2 sacks cement.

RECEIVED
STATE CORPORATION COMMISSION

NOV 24 1959

CONSERVATION DIVISION
Wichita, Kansas

(If additional description is necessary, use BACK of this sheet)
Name of Plugging Contractor Gearhart-Canaday Drilling Company
Address 6427 East Kellogg Wichita, Kansas

STATE OF Kansas, COUNTY OF Sedgwick, ss.
Gerald W. Gearhart (employee of owner) or (owner/operator) of the above-described well, being first duly sworn on oath, says: That I have knowledge of the facts, statements, and matters herein contained and the log of the above-described well as filed and that the same are true and correct. So help me God.

(Signature)

6427 East Kellogg Wichita 7, Kansas

(Address)

SUBSCRIBED AND SWORN to before me this 23rd day of November 1959

Ralph E. Arbogast
Ralph E. Arbogast

Notary Public.

My commission expires 9-15-62.



WELL LOG

COMPANY: Diversified Oil Investments, Inc. LOCATION: SE SE SE 22-29S-2W
 FARM: Tjaden A-1 Sedgwick Co., Ks.
 TOTAL DEPTH: 3040'
 COMMENCED: 11-12-59
 COMPLETED: 11-21-59
 CONTRACTOR: Gearhart-Canaday Drilling Co.
 CASING: 80' of 13" (4 jts.) conductor pipe.
 384' of 8 5/8" (19 jts.) 28# surface casing with 340 sacks
 common cement.

FIGURES INDICATE BOTTOM OF FORMATION

4'	Surface Soil	990'	Lime
17'	Clay	1610'	Lime & Shale Strks.
42'	Gravel	2669'	Shale & Lime
148'	Blue Shale	2715'	Shale - Sand
195'	Red Bed	2784'	Stalnaker - Sand
205'	Blue Shale	2907'	Shale - Lime
336'	Salt	3040'	Lime T. D.
383'	Blue Shale & Lime		
860'	Lime & Shale Strks.		

I, Gerald W. Gearhart, partner in
 Gearhart-Canaday Drilling Company,
 do hereby certify the above rotary
 log to be true and correct to the
 best of my knowledge.

Gerald W. Gearhart
 Gerald W. Gearhart

Subscribed and sworn to before me,
 a notary public in and for Sedgwick
 County, Kansas, this 23rd day of
 November, 1959.

My Commission expires 9-15-62.

Ralph E. Arbogast
 Ralph E. Arbogast

RECEIVED
 STATE CORPORATION COMMISSION
 NOV 24 1959
 CONSERVATION DIVISION
 Wichita, Kansas