


STATE OF KANSAS  
STATE CORPORATION COMMISSION  
Give All Information Completely  
Make Required Affidavit  
Mail or Deliver Report to:  
Conservation Division  
State Corporation Commission  
211 No. Broadway  
Wichita, Kansas

WELL PLUGGING RECORD

Sedgwick County. Sec. 14 Twp. 29 S Rge. -(E) 2 (W)  
Location as "NE/CNW%SW%" or footage from lines SW SW NE  
Lease Owner E. H. Adair Oil Company, et al.  
Lease Name BURCHILL Well No. 1.  
Office Address 1019 East Second Street, Wichita 7, Kansas.  
Character of Well (completed as Oil, Gas or Dry Hole) Dry-hole.  
Date well completed 5-13 1957  
Application for plugging filed 5-13 1957  
Application for plugging approved 5-13 1957  
Plugging commenced 5-13 1957  
Plugging completed 5-13 1957  
Reason for abandonment of well or producing formation Dry-hole.

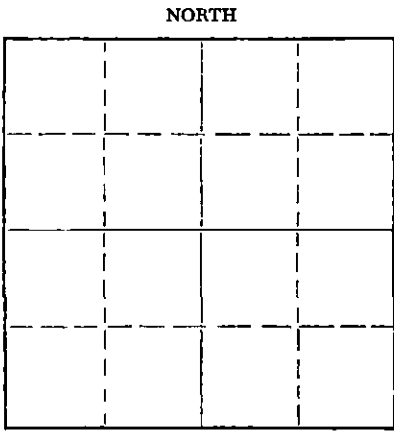

Locate well correctly on above Section Plat

If a producing well is abandoned, date of last production 19  
Was permission obtained from the Conservation Division or its agents before plugging was commenced? Yes.

Name of Conservation Agent who supervised plugging of this well Ruel Durkee  
Producing formation \_\_\_\_\_ Depth to top \_\_\_\_\_ Bottom \_\_\_\_\_ Total Depth of Well 3398 Feet  
Show depth and thickness of all water, oil and gas formations.

OIL, GAS OR WATER RECORDS

CASING RECORD

FORMATION	CONTENT	FROM	TO	SIZE	PUT IN	PULLED OUT
				<u>8-5/8</u>	<u>398</u>	<u>None.</u>

Describe in detail the manner in which the well was plugged, indicating where the mud fluid was placed and the method or methods used in introducing it into the hole. If cement or other plugs used, state the character of same and depth placed, from \_\_\_\_\_ feet to \_\_\_\_\_ feet for each plug set.

Gun pits, fill to 250 feet with heavy mud. Placed wooden plug at 250 ft., put 15 sax. cement through drill-pipe on bottom plug. Filled hole to 15 feet, placed wooden plug at 15 ft.; cemented to surface with 5sax.

(If additional description is necessary, use BACK of this sheet)

Name of Plugging Contractor E. H. Adair Oil Company  
Address 1019 East Second Street, Wichita 7, Kansas.

STATE OF KANSAS, COUNTY OF SEDGWICK, ss.  
K. W. JOHNSON (employee of owner) or ~~(owner or operator)~~ of the above-described well, being first duly sworn on oath, says: That I have knowledge of the facts, statements, and matters herein contained and the log of the above-described well as filed and that the same are true and correct. So help me God.

(Signature) *K.W. Johnson*  
1019 East Second St., Wichita 7, Kans.  
(Address)

SUBSCRIBED AND SWORN TO before me this 21st day of May, 19 57.

My commission expires September 15, 1957.

*[Notary Seal]*  
L. HILL Notary Public.

PLUGGING  
SEC 14 T 29 2W  
BOOK PAGE 13 LINE 44

MAY 21 1957  
5-24-57

E. H. Adair Oil Company  
1019 East Second Street  
Wichita 7, Kansas.

E. H. Adair Oil Company, et al,  
No. 1 Burchell  
SW SW NE of  
Sec. 19-Twp. 29S., R. 2 West,  
Sedgwick County, Kansas.

Comm.: 4-27-57  
Comp.: 5-12-57  
Contractor:  
Adair - Rig No. 3.  
8-5/8 @ 398 ft. w/ 275 sx.

Elevation - 1316 K.B.

Pro. D. & A.

Figures indicate bottoms of Formations

Shale to	140	Lime, porous, to	3124
Shale & shells	234	Lime	3149
Lime & shale	398	Shaley lime	3162
Shale & shells	470	Shale, w/lime	
Anhydrite	515	streaks	3570
Lime & shale	1042	Chert	3574
Sandy lime	1085	Cherty lime &	
Shale & shells	2225	lime	3598
Shale & lime	2698	Dolomite, slight-	
Sand	2790	ly porous	3640
Shale	2952	Shaley lime	3720
Lime	2965	Cherty lime	3758
Lime, show of oil	2970	Dolomitic lime	3818
Lime	3043	Cherty dolomite	3856
Lime, porous	3054	Shaley lime	3875
Lime	3069	Cherty lime	3900
Black shale	3073	Lime	3920
Lime, porous	3100	Shale	3982
Black shale	3102	Sand	3989
Lime	3107	Dolomitic sand	3998

Tops

Stalnaker Sand	2698 (-1382)
K.C. Lime	2952 (-1636)
Base K.C.	3149 (-1833)
Mississippi	3570 (-2254)
Kinderhook Shale	3920 (-2604)
Misener Sand	3982 (-2666)
Simpson	3989 (-2673)
T.D.	3998

DST # 1. 2965-75. Open one (1) hour; fair steady blow.  
Recovered 10 feet slightly oil and gas-cut  
mud; 30 feet muddy salt-water. BHP = 275 lbs.  
in 20 minutes. No flow pressures.

Certified correct:

*K. W. Johnson*  
K. W. Johnson - Geologist.

RECEIVED  
STATE CORPORATION COMMISSION

MAY 24 1957

CONSERVATION DIVISION  
Wichita, Kansas

PLUGGING	
SEC. 19	T. 29 2W
BOOK PAGE 13	LINE 44