
15-173-00185-0000

STATE OF KANSAS
STATE CORPORATION COMMISSION

Give All Information Completely
Make Required Affidavit
Mail or Deliver Report to:
Conservation Division
State Corporation Commission
212 North Market, Insurance Bldg.
Wichita, Kansas

WELL PLUGGING RECORD

NORTH

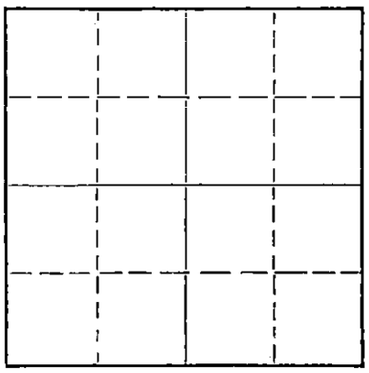

Locate well correctly on above Section Plat

Sedgwick County. Sec. 14 Twp. 29 Rge. 2 (E) W (W)
Location as "NE/CNW¼SW¼" or footage from lines SE SW NW
Lease Owner Brunson-Spines, Inc.
Lease Name McMinn #1 Well No.
Office Address Wichita, Kansas
Character of Well (completed as Oil, Gas or Dry Hole)
Date well completed 19
Application for plugging filed 19
Application for plugging approved 19
Plugging commenced 5-2-60 19
Plugging completed 5-5-60 19
Reason for abandonment of well or producing formation

If a producing well is abandoned, date of last production 19
Was permission obtained from the Conservation Division or its agents before plugging was commenced? yes

Name of Conservation Agent who supervised plugging of this well Lee Gruthrie
Producing formation Depth to top Bottom Total Depth of Well 3601 Feet
Show depth and thickness of all water, oil and gas formations.

OIL, GAS OR WATER RECORDS — CASING RECORD

FORMATION	CONTENT	FROM	TO	SIZE	PUT IN	PULLED OUT
				8-5/8"	361'	none
				5-1/2"	3089'	2631'

Describe in detail the manner in which the well was plugged, indicating where the mud fluid was placed and the method or methods used in introducing it into the hole. If cement or other plugs were used, state the character of same and depth placed, from feet to feet for each plug set.

Checked the hole to 3090' and found it open. Filled w/sand to 3000' and dumped 5 sacks of cement with bailer. Pulled 5½" casing. Cleared hole and check mud to 300'. Set rock bridge from 300' to 280' and dumped 15 sacks of cement. Mudded the hole to 40', set rock bridge to 30' and ran 10 sacks of cement to base of cellar.

RECEIVED
STATE CORPORATION COMMISSION
MAY 13 1960
5-13-60
CONSERVATION DIVISION
Wichita, Kansas

PLUGGING COMPLETED

(If additional description is necessary, use BACK of this sheet)

Name of Plugging Contractor Knight Casing Pulling Co.
Address Chase, Kansas

STATE OF KANSAS, COUNTY OF RICE, ss.

I, Noel J. Knight (employee of owner) or (~~owner or operator~~) of the above-described well, being first duly sworn on oath, says: That I have knowledge of the facts, statements, and matters herein contained and the log of the above-described well as filed and that the same are true and correct. So help me God.

(Signature) Noel Knight

Chase, Kansas
(Address)

SUBSCRIBED AND SWORN TO before me this 7th day of May, 19 60

Thomas V. Boggs
Notary Public.

My commission expires 9-27-62

5441

Knight Cog. Pulling 6
Bof 304
Chase

15-173-00185-0000

BRUNSON-SPINES, INC.
302 Union Center
Wichita 2, Kansas

WELL: McMinn #1 — SE SW NW

COMMENCED RD: 10-19-59 — 14-29-2W

COMPLETED RD: 10-31-59 — SEDGWICK COUNTY, KANSAS

TOTAL DEPTH: 3601 — ELEVATION: 1301 KB

CASING: 8 5/8" 361' Surface - 200 sx cement
5½" 3089' Drill String 75 sx cement — CONTRACTOR: Brunson-Spines, Inc.

STRATA	DEPTH
Surface Soil	15
Sand	25
Shale & Shells	210
Anhydrite	333
Shale	361
Anhydrite&Shale	435
Lime	575
Lime & Shale	925
Lime	1075
Lime & Shale	2935
Lime	3146
Shale	3167
Lime	3324
Lime & Shale	3533
Mississippi Lime	3559
Lime	3601 TD

TOPS		
Stalnaker	2708	(-1407)
Kansas City	2946	(-1645)
Porous Zone #1	2952	(-1651)
Porous Zone #1A	3014	(-1713)
Porous Zone #2	3033	(-1732)
Porous Zone #3	3062	(-1761)
Porous Zone #4	3095	(-1794)
Base of Kansas City	3136	(-1835)
Mississippi Lime	3558	(-2257)
Mississippi Chert	3562	(-2261)

RECEIVED
STATE CORPORATION COMMISSION
MAY 2 1960
CONSERVATION DIVISION
Wichita, Kansas

I hereby certify that the above is a true and correct log of said well as reflected on the daily drilling report.

Ralph B McLaughlin
Ralph B. McLaughlin, Sec'y.-Treas.

Subscribed and sworn to in my presence this 11th day of November, 1959, by Ralph B. McLaughlin, of Brunson-Spines, Inc.

Fay L Jefferson
Fay L. Jefferson, Notary Public.

My Commission Expires: 8-5-63.