


STATE OF KANSAS
STATE CORPORATION COMMISSION

Give All Information Completely
Make Required Affidavit
Mail or Deliver Report to:
Conservation Division
State Corporation Commission
212 North Market, Insurance Bldg.
Wichita, Kansas

WELL PLUGGING RECORD

NORTH

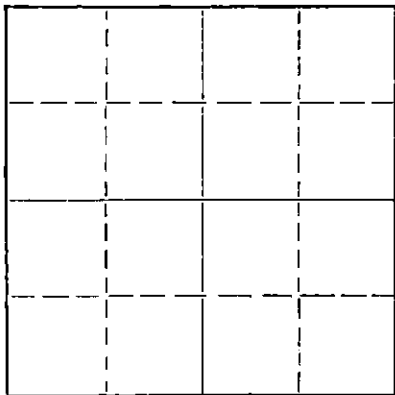

Locate well correctly on above
Section Plat

Sedgwick County, Sec. 7 Twp. 29S Rge. (E) 2 (W)
Location as "NE/CNW/SW" or footage from lines NE NE NE
Lease Owner Stelbar Oil Corporation, Inc.
Lease Name Corr Well No. 1
Office Address 310 Petroleum Bldg., Wichita 2, Kansas
Character of Well (completed as Oil, Gas or Dry Hole) dry hole
Date well completed October 21, 1960
Application for plugging filed October 21, 1960
Application for plugging approved October 21, 1960
Plugging commenced October 21, 1960
Plugging completed October 21, 1960
Reason for abandonment of well or producing formation dry hole

If a producing well is abandoned, date of last production 19
Was permission obtained from the Conservation Division or its agents before plugging was commenced? yes

Name of Conservation Agent who supervised plugging of this well Lee N. Guthrie
Producing formation Depth to top Bottom Total Depth of Well 3677 Feet
Show depth and thickness of all water, oil and gas formations.

OIL, GAS OR WATER RECORDS

CASING RECORD

FORMATION	CONTENT	FROM	TO	SIZE	PUT IN	PULLED OUT
				8-5/8"	467'	

Describe in detail the manner in which the well was plugged, indicating where the mud fluid was placed and the method or methods used in introducing it into the hole. If cement or other plugs were used, state the character of same and depth placed, from feet to feet for each plug set.

Filled with mud to 240', dumped 15 sacks cement, filled with mud to 35', dumped 10 sacks cement, two sacks in rat hole, steel plate welded surface.

RECEIVED
STATE CORPORATION COMMISSION
OCT 28 1960
CONSERVATION DIVISION
Wichita, Kansas

(If additional description is necessary, use BACK of this sheet)
Name of Plugging Contractor Stelbar Oil Corporation, Inc.
Address 310 Petroleum Bldg., Wichita, Kansas

STATE OF Kansas, COUNTY OF Sedgwick, ss.
Bertrand M. Lester, Jr. (employee of owner) or (~~owner or operator~~) of the above-described well, being first duly sworn on oath, says: That I have knowledge of the facts, statements, and matters herein contained and the log of the above-described well as filed and that the same are true and correct. So help me, God.

(Signature) Bertrand M. Lester, Jr.
310 Petroleum Bldg., Wichita, Kansas
(Address)

SUBSCRIBED AND SWORN to before me this 27th day of January, 19 60

My commission expires: January 18, 1964

My commission expires

Leona Hargrove
Leona Hargrove, Notary Public.



LOG

Farm: Corr, Well No. 1
NE NE NE
Sec. 7-29S-2W
Sedgwick County, Kansas

Contractor: Stelbar Oil Corporation, Inc.
Owner: Stelbar Oil Corporation, Inc.
Drilling Commenced: 10-10-60
Drilling Completed: 10-21-60

8-5/8" 467' cemented with 300 sacks

Elevation: Est. 1340 DF, 1337 Gr

0	50	Sand, gravel, Clay
50	550	Broken Lime
550	1180	Shale & Shells
1180	1452	Shale & Lime
1452	2580	Shale & Shells
2580	2664	Lime & Shale
2664	2715	Shale & Shells
2715	2847	Sand
2847	3016	Lime & Shale
3016	3200	K. C. Lime
3200	3453	Lime
3453	3647	Shale & Lime
3647	3677	Mississippi Lime
	3677	RTD

Filled with mud to 240', dumped 15 sacks cement, filled with mud to 35', dumped 10 sacks cement, 2 sacks in rat hole.

RECEIVED
STATE CORPORATION COMMISSION
OCT 28 1960
CONSERVATION DIVISION