

STATE OF KANSAS  
STATE CORPORATION COMMISSION


WELL PLUGGING RECORD

Give All Information Completely  
Make Required Affidavit  
Mail or Deliver Report to:  
Conservation Division  
State Corporation Commission  
211 No. Broadway  
Wichita, Kansas

Sedgwick County. Sec. 2 Twp. 29 Rge. 2 (X) W (W)

Location as "NE/CNWxSWx" or footage from lines SW NE NE  
Lease Owner PETROLEUM, INC.  
Lease Name McLAUGHLIN "B" Well No. 1  
Office Address ROUTE 2, GREAT BEND, KANSAS  
Character of Well (completed as Oil, Gas or Dry Hole) Dry Hole  
Date well completed April 21, 19 58  
Application for plugging filed April 21, 19 58  
Application for plugging approved April 21, 19 58  
Plugging commenced April 21, 19 58  
Plugging completed April 21, 19 58  
Reason for abandonment of well or producing formation No Producing Zones

NORTH

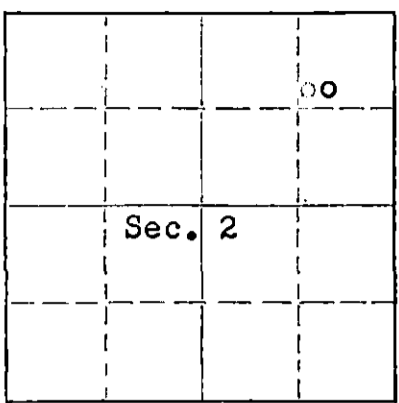

Locate well correctly on above Section Plat

If a producing well is abandoned, date of last production None 19\_\_  
Was permission obtained from the Conservation Division or its agents before plugging was commenced? Yes

Name of Conservation Agent who supervised plugging of this well Eugene Graham, Box 652, Winfield, Kansas  
Producing formation \_\_\_\_\_ Depth to top \_\_\_\_\_ Bottom \_\_\_\_\_ Total Depth of Well 3630' Feet  
Show depth and thickness of all water, oil and gas formations.

OIL, GAS OR WATER RECORDS

CASING RECORD

FORMATION	CONTENT	FROM	TO	SIZE	PUT IN	PULLED OUT
				8-5/8"	450'	None

Describe in detail the manner in which the well was plugged, indicating where the mud fluid was placed and the method or methods used in introducing it into the hole. If cement or other plugs were used, state the character of same and depth placed, from \_\_\_\_\_ feet to \_\_\_\_\_ feet for each plug set.

Mud up with heavy mud to 200' followed by wooden plug. Placed 20 sacks cement through drill pipe on to plug. Mud up to 20' followed by wooden plug and 5 sacks cement to base of well cellar.

4-30-58  
ADD 2-1-58

(If additional description is necessary, use BACK of this sheet)  
Name of Plugging Contractor Garvey Drilling Co.  
Address Route 2, Great Bend, Kansas

STATE OF Kansas COUNTY OF Barton, ss.  
Don Searle (employee of owner) or (owner or operator) of the above-described well, being first duly sworn on oath, says: That I have knowledge of the facts, statements, and matters herein contained and the log of the above-described well as filed and that the same are true and correct. So help me God.

(Signature) Don Searle  
Route 2, Great Bend, Kansas  
(Address)

SUBSCRIBED AND SWORN TO before me this 29th day of April, 19 58

[Signature]  
Notary Public.

My commission expires July 11, 1960

PLUGGING  
2 T. 29 R 2 W  
BOOK PAGE 94 LINE 33

# WELL LOG

COMPANY PETROLEUM, INCORPORATED

SEC. 2 T. 29S R. 2W

FARM MC LAUGHLIN "B" NO. 1

LOC. SW, NE, NE


TOTAL DEPTH 3630'

COUNTY SEDGWICK CO., KANSAS

COMM. April 11, 1958

COMP. April 21, 1958

CONTRACTOR GARVEY DRILLING COMPANY

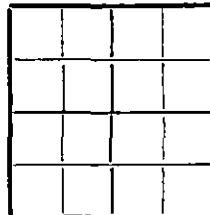

CASING 8 5/8" @ 450' W/275 sax.

ELEVATION 1371' DF

PRODUCTION D & A

FIGURES INDICATE BOTTOM OF FORMATIONS

270	Surface soil, red bed & shale
410	Shale
465	Anhydrite
1160	Lime & shale
2700	Shale & lime
2718	Sand
2929	Shale & sand
3087	Lime
3494	Shale & lime
3528	Lime & chert
3568	Chert
3630	Lime
3630	T. D.

RECEIVED  
STATE CONSERVATION COMMISSION

APR 30 1958

CONSERVATION DIVISION  
Wichita, Kansas

State of KANSAS

County of BARTON

### PLUGGING

FILE SEC 2 T. 29 R. 24  
BOOK PAGE 94 LINE 33

I, VERNE A. MORRIS of GARVEY DRILLING CO.

upon oath state that the above and foregoing is a true and correct copy of the log of the #1 MC LAUGHLIN "B" well

Verne A. Morris

Subscribed and sworn to before me this 29th day of April 19 58

My Commission Expires: July 11, 1960

[Signature]  
NOTARY PUBLIC