


STATE OF KANSAS  
STATE CORPORATION COMMISSION

Form CP-4

WELL PLUGGING RECORD

Give All Information Completely  
Make Required Affidavit  
Mail or Deliver Report to:  
Conservation Division  
State Corporation Commission  
P. O. Box 17027  
Wichita, Kansas 67217  
NORTH

Jedgwick County, Sec. 2 Twp. 29 Rge. 2 (E) W (W)  
Location as "NE/CNWSW" or footage from lines. SW SW NE  
Lease Owner W.D. Short  
Lease Name McLaughlin Well No. #1  
Office Address Box 45, Oxford, Kansas, 67119  
Character of Well (completed as Oil, Gas or Dry Hole) OIL WELL  
Date well completed November 26 1956  
Application for plugging filed April 23 1974  
Application for plugging approved April 23 1974  
Plugging commenced 4-24-74 1974  
Plugging completed 4-26-74 1974  
Reason for abandonment of well or producing formation LOW PROD

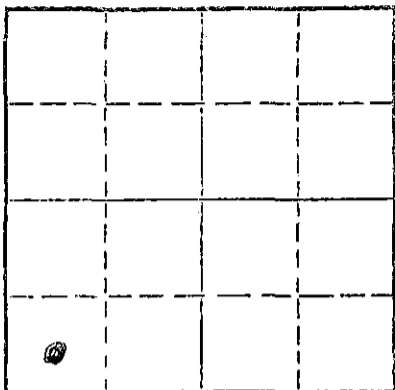

Locate well correctly on above Section Plat

If a producing well is abandoned, date of last production 6-30 1972  
Was permission obtained from the Conservation Division or its agents before plugging was commenced? YES

Name of Conservation Agent who supervised plugging of this well TED Dewey  
Producing formation Mississippi Depth to top 3543 Bottom 2580 Total Depth of Well 3580 Feet  
Show depth and thickness of all water, oil and gas formations.

OIL, GAS OR WATER RECORDS

CASING RECORD

FORMATION	CONTENT	FROM	TO	SIZE	PUT IN	PULLED OUT
				5 1/2	3580'	2758'

Describe in detail the manner in which the well was plugged, indicating where the mud fluid was placed and the method or methods used in introducing it into the hole. If cement or other plugs were used, state the character of same and depth placed, from \_\_\_\_\_ feet to \_\_\_\_\_ feet for each plug set.

FILLED BACK WITH SAND TO 3538 DUMPED  
5 SX Cement ~~AND~~ SET PIPE AT 2758' BAILED  
Hole DOWN SET A ROCK BRIDGE FROM 280 to 250'  
DUMPED 4 YDS. REDI-MIX TO TOP

RECEIVED  
STATE CORPORATION COMMISSION  
MAY 28 1974  
CONSERVATION DIVISION  
Wichita, Kansas

Name of Plugging Contractor B+S CASING Pulling (If additional description (optional), use BACK of this sheet)  
Address 216 S 5TH TOWANDA, KS 67444

STATE OF Kansas, COUNTY OF Sumner, ss.  
W.D. Short (owner or operator) of the above-described well, being first duly sworn on oath, says: That I have knowledge of the facts, statements, and matters herein contained and the log of the above-described well as filed and that the same are true and correct. So help me God.

(Signature) W.D. Short  
Box 45 Oxford Kans 67119 (Address)

Subscribed and sworn to before me this 24th day of May, 1974  
Jan 20, 1976  
MARJORIE O. SHORT  
NOTARY PUBLIC  
SUMNER COUNTY, KANSAS

Marjorie O. Short  
Notary Public.

WELL LOG BUREAU--KANSAS GEOLOGICAL SOCIETY  
508 East Murdock, Wichita, Kansas

COPY


Company. PETROLEUM, INC.  
Farm. McLaughlin No. 1

SEC. 2 T. 29 R. 2W  
SW SW NE

Total Depth. 3580  
Comm. 11-15-56 Ccmp. 11-27-56

County Sedgwick  
KANSAS

Shot or Treated.  
Contractor. Garvey Drilling Co.  
Issued. 7-6-57

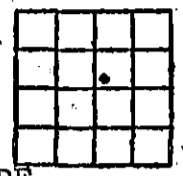

8 5/8 @ CASING: 450' w/ 275 sx cmt.  
5 1/2 @ 3570' w/ 125 sx cmt.

Elevation. 1359 DF

Production. 76 BOPD

Figures indicate Bottom of Formations.

surface soil	25
sand	50
clay & sand	75
shale	195
salt & shale	260
shale & lime	415
anhydrite	435
lime	885
lime & shale	2883
sand & shale	2946
lime	3113
lime & shale	3128
lime	3322
lime & shale	3369
lime	3507
lime & shale	3539
lime	3580
Total Depth	
SCOUT TOPS:	
Heebner	2339
Stalnaker	2649
Kansas City	2932
Mississippi	3540

RECEIVED  
STATE CORPORATION COMMISSION  
NOV 6 1974  
CONSERVATION DIVISION  
Wichita, Kansas