


WELL PLUGGING RECORD

Give All Information Completely
Make Required Affidavit
Mail or Deliver Report to:
Conservation Division
State Corporation Commission
211 No. Broadway
Wichita, Kansas

Sedgwick County, Sec. *2* Twp. *29* Rge. *2 West* (W)
Location as "NE/CNW/SW" or footage from lines *SE SE NW*
Lease Owner *W.D. Short*
Lease Name *Struthers* Well No. *1*
Office Address *Box 45 Oxford, Kans.*
Character of Well (completed as Oil, Gas or Dry Hole) *Oil*
Date well completed *11-20-1956 Nov. 20* 19*56*
Application for plugging filed *March 3* 19*66*
Application for plugging approved *March 3* 19*66*
Plugging commenced *March 26* 19*66*
Plugging completed *March 27* 19*66*
Reason for abandonment of well or producing formation *making 1/4 1966 oil 1 500 bbl
Water*
If a producing well is abandoned, date of last production *Aug* 19*66*
Was permission obtained from the Conservation Division or its agents before plugging was commenced? *yes*

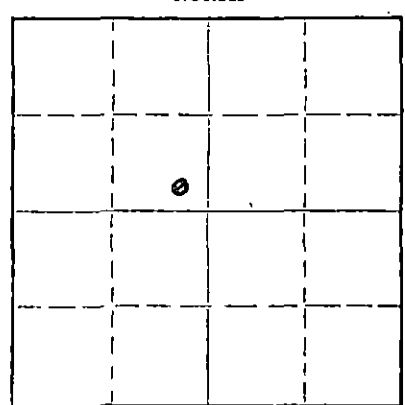

Locate well correctly on above Section Plat

Name of Conservation Agent who supervised plugging of this well *Paul Turpin*
Producing formation *Miss* Depth to top *3551* Bottom *3567* Total Depth of Well *3590* Feet
Show depth and thickness of all water, oil and gas formations.

OIL, GAS OR WATER RECORDS

CASING RECORD

FORMATION	CONTENT	FROM	TO	SIZE	PUT IN	PULLED OUT
<i>Miss</i>		<i>3551</i>	<i>3567</i>	<i>5 1/2</i>	<i>3572</i>	<i>2980</i>
<i>Surface</i>		<i>0</i>	<i>450'</i>	<i>8 3/8</i>	<i>450'</i>	<i>0</i>

Describe in detail the manner in which the well was plugged, indicating where the mud fluid was placed and the method or methods used in introducing it into the hole. If cement or other plugs were used, state the character of same and depth placed, from _____ feet to _____ feet for each plug set.

*Filled hole with sand to 3550 ft. Mixed & dumped 5 sacks
Cement. Ripped & pulled 2980ft of 5 1/2" 14# casing.
Set Rock Bridge from 300' to 185' Added 20 sacks
cement. Mudded hole from this point to 30 ft. Added
10 sacks Cement to Surface*

RECEIVED
STATE CORPORATION COMMISSION
APR 4 1966
RECEIVED
CONSERVATION DIVISION
APR 18 1966
CONSERVATION DIVISION
WICHITA, KANSAS

Name of Plugging Contractor *Paul Sheppard Drilling Co* (If additional description is necessary, use BACK of this sheet)
Address *Winfield, Kansas*

STATE OF *Kansas* COUNTY OF *Sumner*, ss.
W.D. Short (employer or owner) or (operator) of the above-described

well, being first duly sworn on oath, says: That I have knowledge of the facts, statements, and matters herein contained and the log of the above-described well as filed and that the same are true and correct. So help me God.

(Signature) *W.D. Short*
Box 45 Oxford Kansas (Address)

SUBSCRIBED AND SWORN TO before me this *15th* day of *Apr*, 1966

My commission expires *Jan. 31, 1969* *Reta M. Carson* Notary Public.

15-173-01693-0000

WELL LOG

Map #19

W.D. Short 2-29-2W

COMPANY **WOODRIVER OIL & REFINING CO., INC.**

SEC. 2 T. 29S R. 2W

FARM **Struthers** NO. **1**


LOC. **SE,SE,NW**

TOTAL DEPTH **3575'**

COUNTY **Sedgwick Co., Kansas**

COMM. **November 2, 1956** COMP. **November 14, 1956**

CONTRACTOR **GARVEY DRILLING COMPANY**

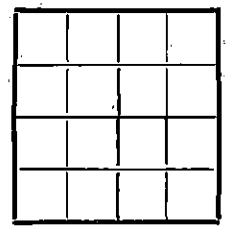

CASING **8 5/8" @ 450' W/300 sax.**
5 1/2" @ 3573' W/125 sax.

ELEVATION **1367' DF**

PRODUCTION

FIGURES INDICATE BOTTOM OF FORMATIONS

27	Surface soil
46	Sand
248	Shale
380	Sand, lime & gravel
400	Salt
420	Shale & lime
450	Anhydrite
700	Lime
970	Lime & shale
1180	Lime
1355	Lime & shale
1490	Shale & shells
2661	Lime & shale
2728	Lime, shale & sand
2761	Ir on pyrite & sand
2932	Lime & shale
2944	Shale
3149	Lime
3394	Lime & s hale
3546	Lime
3551	Lime & shale
3575	Lime
3575	T. D.

RECEIVED
STATE CORPORATION COMMISSION
APR 4 1966
CONSERVATION DIVISION
Wichita, Kansas

State of KANSAS }
County of BARTON } ss:

I, Verne A. Morris of Garvey Drilling Co.

upon oath state that the above and foregoing is a true and correct copy of the log of the #1 Struthers well

Verne A. Morris

Subscribed and sworn to before me this 20th day of November 19 56

My Commission Expires: July 11, 1960

Jed T. Brown
NOTARY PUBLIC