


STATE OF KANSAS
STATE CORPORATION COMMISSION
CONSERVATION DIVISION
P. O. BOX 17027
WICHITA, KANSAS 67217

FORM CP-4

WELL PLUGGING RECORD

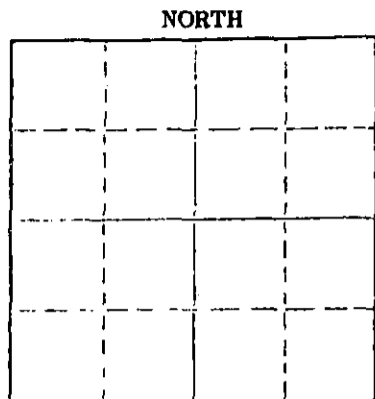

Locate well correctly on above Section Plat

Sedgwick County, Sec. 2 Twp. 29S Rge. (E) 2W

Location as "NE/CNW/SW" or footage from lines NE SW NE

Lease Owner Zorger Oil Company

Lease Name McLaughlin Well No. 1

Office Address 706 Union Nat'l Bldg., Wichita, Kansas 67202

Character of Well (completed as Oil, Gas or Dry Hole) Dry Hole

Date well completed 12-16 19 75

Application for plugging filed 12-16 19 75

Application for plugging approved 12-16 19 75

Plugging commenced 12-16 19 75

Plugging completed 12-16 19 75

Reason for abandonment of well or producing formation No commercial quantities of oil or gas encountered.

If a producing well is abandoned, date of last production 19

Was permission obtained from the Conservation Division or its agents before plugging was commenced? Yes

Name of Conservation Agent who supervised plugging of this well Ted Dewey

Producing formation _____ Depth to top _____ Bottom _____ Total Depth of Well 3610 Feet

Show depth and thickness of all water, oil and gas formations.

OIL, GAS OR WATER RECORDS

CASING RECORD

FORMATION	CONTENT	FROM	TO	SIZE	PUT IN	PULLED OUT
Surface Hole	Water	Surf.	457	8-5/8"	452	None

Describe in detail the manner in which the well was plugged, indicating where the mud fluid was placed and the method or methods used in introducing it into the hole. If cement or other plugs were used, state the character of same and depth placed, from _____ feet to _____ feet for each plug set.

Fluid to 222', plug, 25 sx cement;

Fluid to 40', plug, 10 sx cement;

Two sacks cement in rat hole.

RECEIVED
CONSERVATION DIVISION
WICHITA, KANSAS

JAN 5 1976
1-5-76
CONSERVATION DIVISION
WICHITA, KANSAS

(If additional description is necessary, use BACK of this sheet)

Name of Plugging Contractor D N B DRILLING, INC.

Address 701 First National Building

Wichita, Kansas 67202

STATE OF KANSAS (COUNTY OF _____) ss.

JAMES L. DONELSON

_____, (employee of owner) or (owner or operator) of the above-described well, being first duly sworn on oath, says: That I have knowledge of the facts, statements, and matters herein contained and the log of the above-described well as filed and that the same are true and correct. So help me God.

(Signature) James L. Donelson

701 First Nat'l Building, Wichita, Kansas 67202

(Address)

SUBSCRIBED AND SWORN to before me this 31st day of December, 19 75

Ella Priess

My commission expires 8-25-76

Ella Priess

Notary Public.

Ella Priess
STATE NOTARY PUBLIC
Sedgwick County, Kansas
My Com. Expires Aug. 25, 1976

DRILLERS' LOG

ZORGER OIL COMPANY
No. 1 McLaughlin
NE SW NE, Sec. 2-29S-2W
Sedgwick County, Kansas

Elev: 1357 K.B.

Commenced: 12-7-75
Completed: 12-16-75

Surface Casing: 452' of
8-5/8" cemented w/350 sx
common cement, 2% Gel, 3% cc.
12-8-75

<u>FORMATION</u>	<u>DEPTH</u>
Surface Hole	0 - 457
Lime & Shale	457 - 1050
Shale & Lime	1050 - 2168
Lime & Shale	2168 - 2785
Shale & Lime	2785 - 2937
Lime	2937 - 3143
Lime & Shale	3143 - 3262
Lime	3262 - 3610 RTD

I do hereby certify that the foregoing statements are true and correct to the best of my knowledge and belief.

D N B DRILLING, INC.

James L. Donelson
JAMES L. DONELSON

RECEIVED
STATE CORPORATION COMMISSION

JAN 5 1976

CONSERVATION DIVISION
Wichita, Kansas

STATE OF KANSAS: ss:

Subscribed and sworn to before me this 31st day of December 1975.

Ella Priess

Ella Priess, Notary Public

<i>Ella Priess</i>
STATE NOTARY PUBLIC
Sedgwick County, Kansas
My Com. Expires Aug. 25, 1976