

9

STATE OF KANSAS
STATE CORPORATION COMMISSION


Form CP-4

Give All Information Completely
Make Required Affidavit
Mail or Deliver Report to:
Conservation Division
State Corporation Commission
212 No. Market
Wichita, Kansas

WELL PLUGGING RECORD

SEDGWICK County, Sec. 36 Twp. 29S Rge. 1W ~~SE SE SW~~

Location as "NE/CNW/SW" or footage from lines SE SE SW
Lease Owner REX & MORRIS DRILLING COMPANY, ET AL
Lease Name CARTER Well No. 1
Office Address P. O. BOX 334, EL DORADO, KANSAS 67042
Character of Well (completed as Oil, Gas or Dry Hole) DRY HOLE
Date well completed 24 JUNE 1966
Application for plugging filed 24 JUNE 1966
Application for plugging approved 24 JUNE 1966
Plugging commenced 24 JUNE 1966
Plugging completed 24 JUNE 1966
Reason for abandonment of well or producing formation DRY HOLE

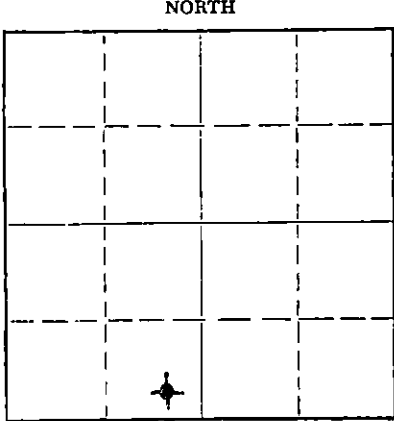

Locate well correctly on above Section Plat

If a producing well is abandoned, date of last production NONE 19
Was permission obtained from the Conservation Division or its agents before plugging was commenced? YES

Name of Conservation Agent who supervised plugging of this well PAUL TURPIN
Producing formation NONE Depth to top _____ Bottom _____ Total Depth of Well 3870' RB Feet
Show depth and thickness of all water, oil and gas formations.

OIL, GAS OR WATER RECORDS

CASING RECORD

FORMATION	CONTENT	FROM	TO	SIZE	PUT IN	PULLED OUT
<u>SURFACE HOLE</u>	<u>WATER</u>	<u>SURFACE</u>	<u>333' RB</u>	<u>8 5/8" OD</u>	<u>327'</u>	<u>LEFT IN</u>
<u>(SEE ATTACHED LOG)</u>						

Describe in detail the manner in which the well was plugged, indicating where the mud fluid was placed and the method or methods used in introducing it into the hole. If cement or other plugs were used, state the character of same and depth placed, from _____ feet to _____ feet for each plug set.

FILLED HOLE WITH 40 VISCOSITY DRILLING MUD TO 200', ADDED 1/2 SACK HULLS, SET A DRY HOLE PLUG AND ADDED 20 SACKS CEMENT. MUDDED HOLE FROM THIS POINT TO 30', ADDED HULLS AND SET A PLUG AND CEMENTED WITH 8 SACKS CEMENT. MUDDED RAT HOLE TO 12' AND CAPPED WITH 2 SACKS CEMENT.

RECEIVED
KANSAS CORPORATION COMMISSION
JUL 22 1966

(If additional description is necessary, use BACK of this sheet)
Name of Plugging Contractor REX & MORRIS DRILLING COMPANY
Address P. O. BOX 334, EL DORADO, KANSAS 67042

STATE OF KANSAS, COUNTY OF BUTLER, ss.
A. H. FISHER (employee of owner) or (owner or operator) of the above-described

well, being first duly sworn on oath, says: That I have knowledge of the facts, statements, and matters herein contained and the log of the above-described well as filed and that the same are true and correct. So help me God.

(Signature) *A. H. Fisher*
P. O. BOX 334, EL DORADO, KANSAS 67042
(Address)

SUBSCRIBED AND SWORN TO before me this 21ST day of JULY, 19 66

My commission expires 5 MAY 1969

Hazel N. Dilts
HAZEL N. DILTS Notary Public.

67

Rex & Morris

36-29-1W

C A R T E R # 1

REX & MORRIS, ETAL

Elevation 1263' RB
1258' GL

TOTAL DEPTH: 3870' RB
CONTRACTOR: REX & MORRIS
COMMENCED: 6-14-66
COMPLETED: 6-24-66
INITIAL PROD.: D & A

Location: SE SE SW
Section 36-29S-1W
Sedgwick County, Kansas
Casing Record: 8 5/8" OD
SET AT 333' RB W/275 Sacks

FORMATION	DEPTH
Surface Hole	333'
Lime & Shale	960'
Shale & Lime	1595'
Lime & Shale	1845'
Lime	2015'
Lime & Shale	2460'
Sand - Stalnaker	2630'
Shale	2791'
Lime - Kansas City	3025'
Shale	3035'
Lime & Shale	3337'
Shale & Lime	3379'
Lime - Mississippi	3766'
Shale - Kinderhook	3829'
Sand - Simpson - R.T.D.	3870'

RECEIVED
STATE CORPORATION COMMISSION
JUL 22 1966
CONSERVATION DIVISION
Wichita, Kansas

I hereby certify the foregoing statements are true and correct to the best of my knowledge and belief.

Rex & Morris Drilling Company

By *A. H. Hikes*

STATE OF KANSAS
COUNTY OF BUTLER, SS.

Subscribed and sworn to before me, a Notary Public, this 21st day of July, 1966.

Harold N. Dilts
Harold N. Dilts, Notary Public

My commission expires: May 5, 1969