

P

STATE OF KANSAS
STATE CORPORATION COMMISSION

WELL PLUGGING RECORD

Give All Information Completely
Make Required Affidavit
Mail or Deliver Report to:
Conservation Division
State Corporation Commission
211 No. Broadway
Wichita, Kansas

Sedgwick County, Sec 34 Twp 29 Rge. 1 (E) 1 (W)

Location as "NE/CNW/SW" or footage from lines SW SW NW

Lease Owner Shawver Armour, Inc.

Lease Name Christian Well No. 1

Office Address 817 Central Building, Wichita, Kansas

Character of Well (completed as Oil, Gas or Dry Hole) Dry Hole

Date well completed April 20, 19 62

Application for plugging filed April 20, 19 62

Application for plugging approved April 20, 19 62


Plugging commenced April 20, 19 62

Plugging completed April 20, 19 62

Reason for abandonment of well or producing formation _____

If a producing well is abandoned, date of last production _____ 19 _____

Was permission obtained from the Conservation Division or its agents before plugging was commenced? yes

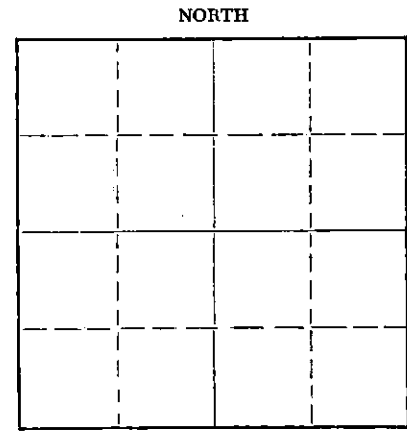

Locate well correctly on above Section Plat

Name of Conservation Agent who supervised plugging of this well Mr. Howard Hess

Producing formation _____ Depth to top _____ Bottom _____ Total Depth of Well 3815 Feet

Show depth and thickness of all water, oil and gas formations.

OIL, GAS OR WATER RECORDS

CASING RECORD

FORMATION	CONTENT	FROM	TO	SIZE	PUT IN	PULLED OUT
surface	water	-0-	318'	8 5/8"	318'	none

Describe in detail the manner in which the well was plugged, indicating where the mud fluid was placed and the method or methods used in introducing it into the hole. If cement or other plugs were used, state the character of same and depth placed, from _____ feet to _____ feet for each plug set.

Heavy mud to 240'

#1 Plug 240' Howco plug 1/4 sack Hulls 20 sacks cement

Heavy mud to 30'

2 Plug 30' Howco Plug 1/4 sack hulls 8 sacks cement

Bridged rat hole down 6 ft w/2 sacks

RECEIVED
STATE CORPORATION COMMISSION

APR 7 1962

CONSERVATION DIVISION
Wichita, Kansas

(If additional description is necessary, use BACK of this sheet)

Name of Plugging Contractor Shawver Armour, Inc.
Address 817 Central Building, Wichita, Kansas

STATE OF KANSAS, COUNTY OF Sedgwick, ss.
James M. Armour (employee of owner) or (owner or operator) of the above-described well, being first duly sworn on oath, says: That I have knowledge of the facts, statements, and matters herein contained and the log of the above-described well as filed and that the same are true and correct. So help me God.

(Signature) James M. Armour
James M. Armour, 817 Central Bldg.,
Wichita, Kansas
(Address)

SUBSCRIBED AND SWORN TO before me this 26th day of December April, 19 62

My commission expires December 29th, 1963

Marjorie Hall
Marjorie Hall Notary Public.

DRILLER'S LOG

FARM NAME: CHRISTIAN # 1 LOCATION: SW SW NW Sec. 34-29S-1W Sedgwick County, Kansas
CONTRACTOR: SHAWVER ARMOUR, INC.
OWNER: Shawver Armour, Inc. ELEVATION: 1262 K B. Lario Oil & Gas Co.
COMMENCED: April 9, 1962 COMPLETED: April 20, 1962
CASING RECORD: 318' 8 5/8" W/225 sacks cement & 5 sacks cc

FORMATION:

TOPS:

Anhydrite & Shale 485
Lime & Shale 1040
Shale & Lime 1510
Lime & Shale 1845
Shale & Lime 2506
Stalnaker Sand 2647
Shale & Lime 2840
T. Kansas City 2906
Lime 3051
Lime & Shale 3408
T. Mississippian 3416
Lime 3746
T. Kinderhook 3745
Kinderhook Shale 3794
T. Simpson 3801
Sand 3815
Rotary Total Depth 3815

Stalnaker 2506
Kansas City 2840
Mississippian 3408
Kinderhook 3745
Simpson 3794

RECEIVED
STATE CORPORATION COMMISSION

APR 27 1962

CONSERVATION DIVISION
Wichita, Kansas

STATE OF KANSAS)
SEDGWICK COUNTY) ss

I, James M. Armour, do hereby certify that the above log is a true and correct copy of the above captioned well as shown on the daily drilling reports.

SHAWVER ARMOUR, INC.

BY James M. Armour
James M. Armour

Subscribed and sworn to before me this 26th day of April, 1962.

My commission expires Dec. 29th, 1963

Marjorie Hall
Marjorie Hall, Notary Public