
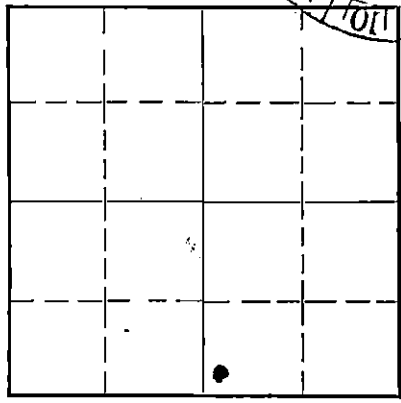


STATE OF KANSAS
STATE CORPORATION COMMISSION
Give All Information Completely
Make Required Affidavit
Mail or Deliver Report to:
Conservation Division
State Corporation Commission
800 Bittling Building
Wichita, Kansas

WELL PLUGGING RECORD
OR
FORMATION PLUGGING RECORD

Strike out upper line
when reporting plug-
ging off formations.

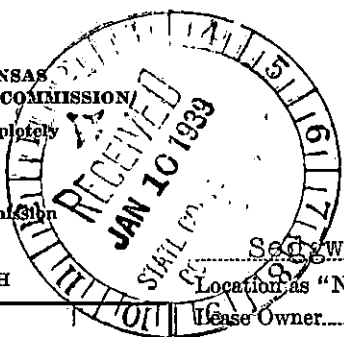

Locate well correctly on above
Section Flat


Location as "NE $\frac{1}{4}$ NW $\frac{1}{4}$ SW $\frac{1}{4}$ " or footage from lines
Lease Owner
Lease Name Murphy Well No. 1
Office Address
Character of Well (Completed as Oil, Gas or Dry Hole) Dry hole
Date, well completed November 11 1938
Application for plugging filed " 12 1938
Application for plugging approved " 12 1938
Plugging Commenced " 12 1938
Plugging Completed " 18 1938
Reason for abandonment of well or producing formation Dry hole
If a producing well is abandoned, date of last production 193
Was permission obtained from the Conservation Division or its agents before plugging was commenced?
Yes

Name of Conservation Agent who supervised plugging of this well
Producing formation Depth to top Bottom Total Depth of Well 3925 Feet.
Show depth and thickness of all water, oil and gas formations.
OIL, GAS OR WATER RECORDS CASING RECORD

Formation	Content	From	To	Size	Put In	Pulled Out
Water at 20'	Water at 2845'			20"	63'	63'
" " 70'	" " 3920'			15"	235'	235'
" " 220'				12"	996'	996'
" " 985'				10"	1725'	1725'
" " 1710'				8 $\frac{1}{4}$ "	2985'	2985'
" " 2060'				6 5-8"	3422'	3422'
" " 2360'						
" " 2420'						

Describe in detail the manner in which the well was plugged, indicating where the mud fluid was placed and the method or methods used in introducing it into the hole. If cement or other plugs were used, state the character of same and depth placed, from feet to feet for each plug set.

Mudded hole before pulling each string of pipe,
up to a depth of 110 feet, where cement plug was
set 15 ' deep.
Hole filled with mud with cement cap on top.

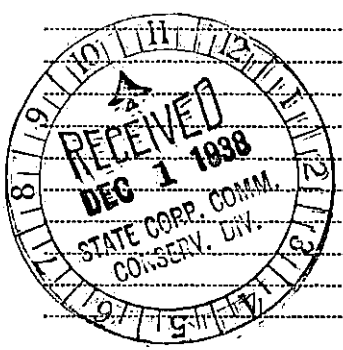

PLUGGING
FILE SEC 34-29-1W
BOOK PAGE 43 LINE 3

(If additional description is necessary, use BACK of this sheet)
Correspondence regarding this well should be addressed to R. E. Hess & Son
Address 150 So. Poplar Wichita, Kansas

STATE OF , COUNTY OF , ss.
 (employee of owner) or (owner or operator) of the above-described well,
being first duly sworn on oath, says: That I have knowledge of the facts, statements, and matters herein contained and the log of the above-described
well as filed and that the same are true and correct. So help me God.

NOT NOTARIZED (Signature) R. E. Hess & Son
by R. E. Hess

SUBSCRIBED AND SWORN to before me this 7th day of Jan., 1939
My commission expires OCT. 14, 1941
Edmund [Signature] (Address)
Notary Public.

R. E. HESS & SON

DRILLING CONTRACTORS

RUSSELL, KANSAS

MURPHY NO. 1
SEC. 34 TWP. 29 RANGE 1WCom. drilling Sept. 8th
Comp. drilling Nov. 11thLOG

Soil	5	Lime sandy	993	Shale	1840
Yellow clay	20	Lime	996	Lime	1945
Sand	50	Shale	1000	Shale	1988
Shale	70	Lime	1015	Lime	1990
Shale	80	Shale	1020	Shale black	1995
Shale blue	140	Lime	1040	Lime	2010
Red rock	145	Shale light	1060	Shale	2015
Shale blue	220	Shale blue	1065	Lime	2025
Gyp salt	235	Shale & shells	1080	Shale	2040
Shale	245	Shale	1090	Lime	2170
Lime	255	Lime	1095	Shale	2175
Shale	260	Shale	1110	Lime	2180
Lime	280	Lime	1130	Shale	2195
Sandy lime	295	Shale	1135	Lime	2205
Shale blue	310	Lime	1155	Shale	2215
Lime	320	Shale	1160	Lime	2245
Shale blue	325	Lime	1165	Shale black	2255
Lime	330	Shale	1175	Shale grey	2265
Shale & shells	340	Lime	1190	Lime	2275
Lime	380	Shale	1240	Shale blue	2295
Lime broken	390	Lime	1250	Lime	2325
Shale blue	395	Shale dark	1270	Shale	2335
Lime	410	Lime	1275	Lime	2340
Shale blue	415	Shale	1285	Shale	2360
Lime	440	Lime	1300	Lime sandy	2370
		Shale	1320	Shale	2515
		Shale & shells	1365	Lime	2520
		Shale light	1380	Sand & shale	2670
		Shale blue	1410	Lime	2680
Red rock	595	Lime	1415	Shale & shells	2735
Lime	625	Shale	1455	Shale dark	2845
Shale	635	Lime	1460	Lime	2905
Lime	745	Shale & shells	1520	Lime sandy	2960
Shale	755	Lime	1550	Lime	2967
Lime	760	Shale & shells		Shale black	2970
Shale blue	770			Lime	3035
Lime	815			Shale	3040
Lime broken	825			Lime	3055
Lime	835			Shale black	3095
Shale blue	840			Lime	3105
Shale red	845			Shale	3120
Lime	870			Lime	3125
Shale blue	880			Shale	3135
red rock	885	Top of Topeka	1725	Lime	3150
Lime	890	Lime	1730	Shale & shells	3175
Shale	905	Shale	1735	Lime	3190
Lime	920	Lime	1755	Shale & shells	3295
Red rock	925	Shale	1765	Lime	3315
Lime	945	Lime	1770	Shale	3325
Shale	960	Shale	1775	Lime	3330
Lime	970	Lime	1790	Shale	3335
Shale blue	980	Shale	1815	Red rock	3345
Lime	985	Lime	1835		

PLUGGINGFILE SEC 34 T 29 R 1 W
BOOK PAGE 42 LINE 3

R. E. HESS & SON

DRILLING CONTRACTORS

RUSSELL, KANSAS

MURPHY NO.1
SEC. 34 TWP. 29 RANGE 1W

LOG

(continued)

Shale & shells	3365
Shale	3390
Chatty lime	3403
Conglomerate	3420
Lime	3750
Shale	3755
Lime	3765
Shale green	3770
Lime	3780
Shale black	3835
Sand	3858
Shale	3866
Lime	3873
Shale	3875
Lime	

Total depth 3925

CASING RECORD

20"	casing	63'
15"	"	235'
12 $\frac{1}{2}$ "	"	996'
10"	"	1725'
8 $\frac{1}{2}$ "	"	2985'
6 5-8"	"	3422'

WATER RECORD

Water at	20'
"	" 70'
"	" 220'
"	" 985'
"	" 1710'
"	" 2060'
"	" 2360'
"	" 2820'
"	" 2845'
"	" 3920'

TOTAL DEPTH
3925'

