

Give All Information Completely
Make Required Affidavit
Mail or Deliver Report to:
Conservation Division
State Corporation Commission
212 No. Market
Wichita, Kansas

WELL PLUGGING RECORD

15-191-20164-0000
Form CP-4

SUMNER

County. Sec. 18 Twp. 30 Rge. 2 (E) W (W)

Location as "NE/CNW/SW" or footage from lines C NE SW

Lease Owner KATHOL PETROLEUM, INC.

Lease Name Kerschen Well No. 1

Office Address 900 Sutton Place, Wichita, Kansas

Character of Well (completed as Oil, Gas or Dry Hole) D & A

Date well completed 10/30 19 69

Application for plugging filed 19

Application for plugging approved 10/31 19 69


Plugging commenced 10/30 19 69

Plugging completed 10/30 19 69

Reason for abandonment of well or producing formation D & A

If a producing well is abandoned, date of last production 19

Was permission obtained from the Conservation Division or its agents before plugging was commenced?

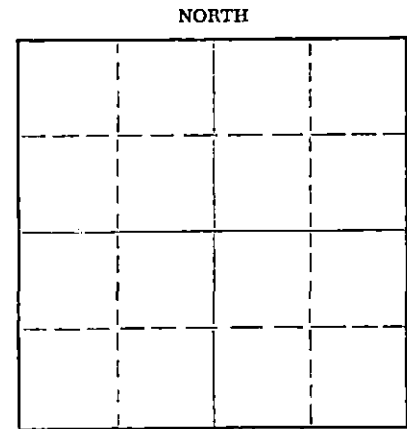

Locate well correctly on above Section Plat

Name of Conservation Agent who supervised plugging of this well H. E. Hess

Producing formation Depth to top Bottom Total Depth of Well 3815 Feet

Show depth and thickness of all water, oil and gas formations.

OIL, GAS OR WATER RECORDS

CASING RECORD

FORMATION	CONTENT	FROM	TO	SIZE	PUT IN	PULLED OUT
				8 5/8	242	None

RECEIVED
STATE CORPORATION COMMISSION
NOV 25 1969 11-25-69
CONSERVATION DIVISION
Wichita, Kansas

Describe in detail the manner in which the well was plugged, indicating where the mud fluid was placed and the method or methods used in introducing it into the hole. If cement or other plugs were used, state the character of same and depth placed, from feet to feet for each plug set.

Filled hole to 235' w/ heavy mud
Set Plug w 1/2 sx hulls and 25 sx.
cement Filled hole to 40' w/ heavy
mud Set plug w 1/2 sx hulls and 10
sx. cement 2 sx. cement in rat hole.

(If additional description is necessary, use BACK of this sheet)

Name of Plugging Contractor KATHOL PETROLEUM, INC.

Address 900 Sutton Place, Wichita, Kansas

STATE OF KANSAS, COUNTY OF SEDGWICK, ss.
Homer J. Catt (employee of owner) or ~~owner or operator~~

well, being first duly sworn on oath, says: That I have knowledge of the facts, statements, and matters herein contained and the log of the above-described well as filed and that the same are true and correct. So help me God.

(Signature) Homer J. Catt


900 Sutton Place, Wichita, Kansas

(Address)

SUBSCRIBED AND SWORN to before me this 21st day of November 1969

June 17, 1972

Dixie Lee Brown
Notary Public.

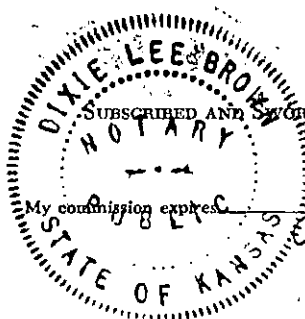



DRILLERS LOG

#1 KERSCHEN

CASING RECORD:	OPERATOR: Kathol Petroleum, Inc.	DESCRIPTION:
8 5/8" @ 242' w/200 sacks cement.	CONTRACTOR: Kathol Petroleum, Inc.	C. NE SW Sec. 18-30S-2W Sumner Co., Kansas
	COMMENCED: October 17, 1969	
Total Depth:	COMPLETED: October 30, 1969	Elevation:
3815'	I.P. Plugged & Abandoned	1367' DF 1370' KB

<u>FORMATION</u>	<u>FROM</u>	<u>TO</u>	<u>REMARKS</u>
shale	0	100	
shale & lime	100	415	
shale & shells	415	640	
shale & lime	640	925	
lime & shale	925	1235	
shale & lime	1235	1890	
shale	1890	2200	
shale & lime	2200	2710	
shale & sand	2710	2920	
lime & shale	2920	3020	
shale & lime	3020	3130	
lime	3130	3485	
shale w/lime	3485	3580	
lime & shale	3580	3615	
lime	3615	3705	
shale & lime	3705	3785	
lime	3785	3815 T.D.	

RECEIVED
STATE CORPORATION COMMISSION
NOV 25 1969
CONSERVATION DIVISION
Wichita, Kansas

I hereby certify that the above information is true and correct to the best of my knowledge.

KATHOL PETROLEUM, INC.

Don D. Shawver

Don D. Shawver

Subscribed and sworn to before me this 19th day of November, 1969.

Betty M. Maloney

Betty M. Maloney, Notary Public

My Commission Expires:

