


STATE OF KANSAS  
STATE CORPORATION COMMISSION  
Give All Information Completely  
Make Required Affidavit  
Mail or Deliver Report to:  
Conservation Division  
State Corporation Commission  
800 Bitting Building  
Wichita, Kansas

WELL PLUGGING RECORD

NORTH

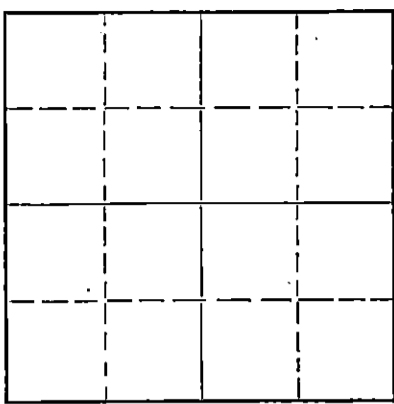

Locate well correctly on above Section Plat

Summer County. Sec. 18 Twp. 30S Rge. (E) 2 (W)  
Location as "NE/CNW&SW" or footage from lines NW NW SW  
Lease Owner Aladdin Petroleum Corporation  
Lease Name Kerschen Well No. 1  
Office Address 809 Petroleum Bldg., Wichita, Kansas  
Character of Well (completed as Oil, Gas or Dry Hole) Dry hole  
Date well completed October 29 1955  
Application for plugging filed October 28 1955  
Application for plugging approved October 28 1955  
Plugging commenced October 29 1955  
Plugging completed October 29 1955  
Reason for abandonment of well or producing formation No shows

If a producing well is abandoned, date of last production 19  
Was permission obtained from the Conservation Division or its agents before plugging was commenced? Yes

Name of Conservation Agent who supervised plugging of this well W. S. Lemaster, Arkansas City  
Producing formation \_\_\_\_\_ Depth to top \_\_\_\_\_ Bottom \_\_\_\_\_ Total Depth of Well 4264 Feet GM  
Show depth and thickness of all water, oil and gas formations.

OIL, GAS OR WATER RECORDS

CASING RECORD

FORMATION	CONTENT	FROM	TO	SIZE	PUT IN	PULLED OUT
				8-5/8"	310'	None

Describe in detail the manner in which the well was plugged, indicating where the mud fluid was placed and the method or methods used in introducing it into the hole. If cement or other plugs were used, state the character of same and depth placed, from \_\_\_\_\_ feet to \_\_\_\_\_ feet for each plug set.

Mud from 4264' to 300'  
Plugged with 15 sack cement at 300'  
Filled with mud to 50'  
Plugged with 10 sacks cement 50' to 0'.

(If additional description is necessary, use BACK of this sheet)

Name of Plugging Contractor Crowe Drilling Company  
Address W. K. H. Building, Wichita, Kansas

STATE OF Kansas, COUNTY OF Sedgwick, ss.  
J. M. Johnson, Vice President (employee of owner) or (owner or operator) of the above-described well, being first duly sworn on oath, says: That I have knowledge of the facts, statements, and matters herein contained and the log of the above-described well as filed and that the same are true and correct. So help me God, J. M. Johnson

(Signature) [Signature]  
809 Petroleum Bldg., Wichita, Kansas  
(Address)

SUBSCRIBED AND SWORN TO before me this 4th day of November, 19 55

[Signature]  
Notary Public.

My commission expires July 13, 1959

PLUGGING  
FILE DEC 18 1955  
BOOK PAGE 12 LINE 22

11-10-55

DISTRICT CONSERVATION AGENT'S REPORT

*R*

TO:

State Corporation Commission  
Conservation Division  
800 Bitting Building  
Wichita, Kansas

FILE NO. NEW.

LOCATION NW--NW--SW.

SEC. 18-TWP. 30 RGE. 2West.

Dry Hole YES Abandoned Oil Well \_\_\_\_\_ Abandoned Gas Well \_\_\_\_\_

I have today completed supervision of plugging of:

Well No. ONE Lease KERSCHEN. 609  
*Aladdin*  
Operator Aladden petroleum Corp Address Petroleum Bldg. Wichita Kansas.

Field \_\_\_\_\_ County SUMNER.

Total Depth 4264 Feet.

(Describe briefly the manner in which the well was plugged)

Heavy mud to bottom of Surface pipe <sup>At 320 ft.</sup> set Halliburton plug and Bridged  
then dumped 15 sacks Cemenet then heavy mud to 30 ft of top set a  
Halliburton plug and bridged then dumped 10 scaks Cemenet filling to  
ground leavel then welded cap on top of Surfcae pipe....

**PLUGGING**  
PAGE SEC 18 TWP 30 R2W  
BOOK PAGE 13 LINE 22

RECEIVED  
STATE CORPORATION COMMISSION  
OCT 31 1955  
CONSERVATION DIVISION  
Wichita, Kansas

*W. G. Buffington*  
District Conservation Agent

Date P.M. OCT.. " (\*\*%#)...  
OCT. 29--55...

COMPANY: ALADDIN PETROLEUM CORPORATION  
CONTRACTOR: CROWE DRILLING CO., INC.

FARM: KERSCHEN #1  
LOCATION: NW NW SW  
Sec. 18-30S-2W  
Summer County, Kansas

COMMENCED: October 9, 1955  
COMPLETED: October 29, 1955  
PRODUCTION: D & A  
ELEVATION: 1355' GR

CASING RECORD:  
8-5/8" casing set at  
310' with 275 sacks  
cement.

<u>FORMATIONS</u>	<u>DEPTH</u>
Surface clay	35'
Lime and shale	1220'
Sandy lime and shale	1235'
Lime and shale	2130'
Topeka Lime	2235'
Shale and lime	2800'
Stalnaker	2794'
Sand	2045'
Shale	2950'
Lime and shale	3155'
Lime	3190'
Lime and shale	3740'
Top Mississippi	3728'
Lime	3820'
Lime and shale	4150'
Lime	4138'
Sand	4190'
Sand and shale	4242'
Arbuckle Dolomite	4256'
Lime	4264'
TOTAL DEPTH	4264' GM
KANSAS CITY	3110' GM
MISSISSIPPI CONGLOMERATE	3715' GM
SIMPSON	4142' GM
ARBUCKLE	4240' GM

I hereby certify this to be a true and accurate log of  
the above described well, as shown by the Daily Drilling Reports.

CROWE DRILLING COMPANY, INC.

*B. B. Browne*

Subscribed and sworn to before me this 1st day of November, 1955.

*Emma Dominick*  
Notary Public

My commission expires June 21, 1958

PLUGGING  
WELL SEC. 18-30S-2W  
BOOK PAGE 12 LINE 22