


STATE OF KANSAS  
STATE CORPORATION COMMISSION

WELL PLUGGING RECORD

Give All Information Completely  
Make Required Affidavit  
Mail or Deliver Report to:  
Conservation Division  
State Corporation Commission  
800 Bitting Building  
Wichita, Kansas

Sumner County, Sec. 17 Twp. 30 Rge. (E) 2 (W)  
Location as "NE/CNW/4SW/4" or footage from lines 1080 FSL, 1300 FEL  
Lease Owner Eckland & Drilling & Co. et al  
Lease Name Shinn Well No. 1  
Office Address  
Character of Well (completed as Oil, Gas or Dry Hole) Dry hole  
Date well completed March 23, 1950 19  
Application for plugging filed March 23, 1950 19  
Application for plugging approved March 23, 1950 19  
Plugging commenced March 23, 1950 19  
Plugging completed March 23, 1950 19  
Reason for abandonment of well or producing formation Dry

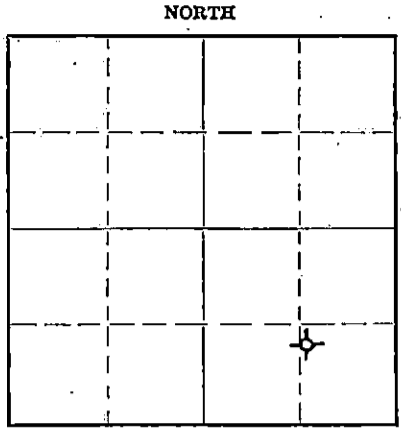

Locate well correctly on above  
Section Plot

If a producing well is abandoned, date of last production 19  
Was permission obtained from the Conservation Division or its agents before plugging was commenced?

Name of Conservation Agent who supervised plugging of this well  
Producing formation Depth to top Bottom Total Depth of Well Feet  
Show depth and thickness of all water, oil and gas formations.

OIL, GAS OR WATER RECORDS

CASING RECORD

Formation	Content	From	To	Size	Put In	Pulled Out

Describe in detail the manner in which the well was plugged, indicating where the mud fluid was placed and the method or methods used in introducing it into the hole. If cement or other plugs were used, state the character of same and depth placed, from feet to feet for each plug set.

Filled hole with heavy mud to bottom of surface 90'  
put in plug and cemented with 15 sacks of cement  
put in mud to 40' and cemented with 10 sacks of cement  
cut off subfave pipe 18" below ground level.

RECORDED  
JUN 7 X 1950  
STATE CORPORATION COMMISSION  
KANSAS

(If additional description is necessary, use BACK of this sheet)

Correspondence regarding this well should be addressed to Eckland Drilling Company  
Address 218 Bissantz Building  
Wichita, Kansas

STATE OF Kansas, COUNTY OF Sedgwick, ss.  
P. A. Eckland (employee of owner) or (owner or operator) of the above-described well,  
being first duly sworn on oath, says: That I have knowledge of the facts, statements, and matters herein contained and the log of the above-described well as filed and that the same are true and correct. So help me God.

(Signature) P. A. Eckland  
(Address)

SUBSCRIBED AND SWORN to before me this 5th day of June, 1950.  
C. R. Haden  
Notary Public.

My commission expires November 18, 1952  
22-5133-9 9-48-10M

PLUGGING  
FILE SEC 17 T 30 R 20  
BOOK PAGE 144 LINE 12

Approx.  
NW-SE-SE

LOCATION: Shinn #1  
~~S/2 NE/4~~ Sec. 17-30-2W  
Sumner County, Kansas

COMPANY: Porter, Turpin et al  
Contractor: Eckland Drilling Co.

Casing: 97' 9" 8 5/8"  
Cement: 50 sacks

Commenced: 3-13-50

Completed: 3-23-50  
Dry Hole

ROTARY DEPTH: 3285

35	Surface clay
45	water gravel
90	shale and shells
285	shale and shells
525	shale and shells
535	salt
580	lime and shale
615	shale and lime
640	anhydrite and shale
775	shale and lime
950	lime and shale
1095	lime and shale
1275	lime and shale
1410	lime and shale
1675	shale and shells
1750	lime and shale
1875	lime and shale
1925	sandy lime
2050	lime
2220	lime
2325	lime
2415	sandy lime and shale
2465	lime and shale
2570	lime
2675	shale and lime
2780	shale and lime
2860	shale and lime
2895	sandy lime
2955	shale and lime
3055	lime and shale
3086	shale
3135	lime K. C.
3167	lime
3210	lime
3285	lime and shale

RECEIVED

JUN 2 1950

**PLUGGING**  
 PRE SEC 17 T 30 R 2W  
 BOOK PAGE 149 LINE 12