


STATE OF KANSAS  
STATE CORPORATION COMMISSION

Give All Information Completely  
Make Required Affidavit  
Mail or Deliver Report to:  
Conservation Division  
State Corporation Commission  
800 Bitting Building  
Wichita, Kansas

WELL PLUGGING RECORD

Sumner County, Sec. 17 Twp. 30S Rge. 2W (E) (W)  
Location as "NE/CNW/SW" or footage from lines NW NW SW  
Lease Owner McNeish & Gralapp  
Lease Name Johnson Well No. 1  
Office Address 528 State Bank Bldg., Winfield, Kansas  
Character of Well (completed as Oil, Gas or Dry Hole) Dry Hole  
Date well completed 1-9-56 19  
Application for plugging filed 1-9-56 19  
Application for plugging approved 1-9-56 19  
Plugging commenced 1-9-56 19  
Plugging completed 1-9-56 19  
Reason for abandonment of well or producing formation

NORTH

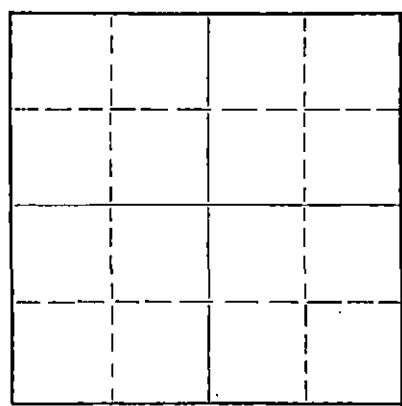

Locate well correctly on above  
Section Plat

If a producing well is abandoned, date of last production 19  
Was permission obtained from the Conservation Division or its agents before plugging was commenced? yes

Name of Conservation Agent who supervised plugging of this well W. G. Buffington  
Producing formation Depth to top Bottom Total Depth of Well Feet  
Show depth and thickness of all water, oil and gas formations.

OIL, GAS OR WATER RECORDS

CASING RECORD

FORMATION	CONTENT	FROM	TO	SIZE	PUT IN	PULLED OUT

Describe in detail the manner in which the well was plugged, indicating where the mud fluid was placed and the method or methods used in introducing it into the hole. If cement or other plugs were used, state the character of same and depth placed, from feet to feet for each plug set.

Cement from 382 1/4 to 310, plug; mud from 310 to 35 ft.; plug;  
10 sacks of cement from 35 ft. to top.

(If additional description is necessary, use BACK of this sheet)

Name of Plugging Contractor Watson Drilling Co., Inc. rotary contractor  
Address 528 State Bank Bldg., Winfield, Kansas

STATE OF Kansas COUNTY OF Cowley, ss.  
Geo. T. McNeish, one of operators (employee of owner) or (owner or operator) of the above-described well, being first duly sworn on oath, says: That I have knowledge of the facts, statements, and matters herein contained and the log of the above-described well as filed and that the same are true and correct. So help me God.

(Signature) *Geo. T. McNeish*  
Winfield, Kansas (Address)

SUBSCRIBED AND SWORN TO before me this 16th day of January, 19 56

My commission expires April 9, 1957

*George H. Hall*  
Notary Public.

PLUGGING  
FEB SEC 17 T 30 R 2W  
BOOK PAGE 31 LINE 14

JAN 16 1956 1-16-56  
CONSERVATION DIVISION  
Wichita, Kansas

WELL LOG

Company: McNeish & Gralapp  
Winfield, Kansas

FARM: Johnson  
NW NW SW 17-30S-2W  
Sumner County, Kans.

Contractor: Watson Drilling Co., Inc.  
Winfield, Kansas.

Comm: 12-20-55  
Comp: 1- 9-56

Casing Record: 318 of 5 5/8" surface  
set with 250 sacks cement.

shale & lime shells	0	185
shale & lime	185	318
shale & shells	318	535
shale & lime	535	1390
shale	1390	1620
shale & lime	1620	1900
shale	1900	1945
shale & lime	1945	2170
shale	2170	2315
lime & shale	2315	2360
sand & shale	2360	2400
shale & lime	2400	2535
shale	2535	2590
sand	2590	2630
shale	2630	2715
shale & lime strks.	2715	2800
shale & sand strks.	2800	2823
lime	2823	2825
sand & shale	2825	2901
shale	2901	2920
sand & shale	2920	2946
shale	2946	2987
shale & lime strks	2987	3095
lime (KC)	3095	3210
lime & sandy lime	3210	3248
lime	3248	3340
shale & lime	3340	3414
lime	3414	3505
lime & shale	3505	3535
lime	3535	3589
lime & shale	3589	3727
lime Mississippi	3727	3834

T. D. 3834'

Plugged cement from 3834' to 310' & plug;  
mud from 310' to 35' & plug; cement from 35'  
to 0'.

**PLUGGING**  
FILE SEC 17 T 30 R 2W  
DOCK PAGE 31 LINE 14