


STATE OF KANSAS
STATE CORPORATION COMMISSION

Form CP-4

WELL PLUGGING RECORD

Give All Information Completely
Make Required Affidavit
Mail or Deliver Report to:
Conservation Division
State Corporation Commission
212 No. Market
Wichita, Kansas

Sumner County, Sec. 10 Twp. 30S Rge. 3 (E) W (W)
Location as "NE/CNW/SW" or footage from lines C SW SW
Lease Owner Leben Drilling, Inc.
Lease Name Plett Well No. 1
Office Address 815 Wichita Plaza, Wichita, Kansas
Character of Well (completed as Oil, Gas or Dry Hole) Dry Hole
Date well completed 6-28 19 69
Application for plugging filed 6-28 19 69
Application for plugging approved 6-28 19 69
Plugging commenced 6-28 19 69
Plugging completed 6-28 19 69
Reason for abandonment of well or producing formation Dry Hole

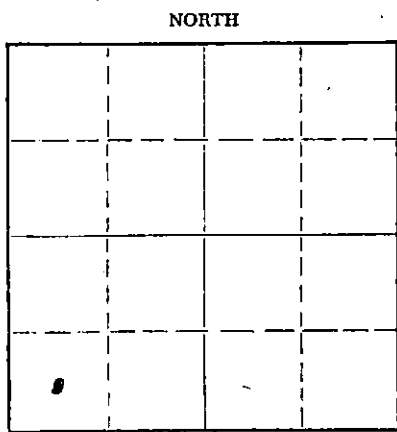

Locate well correctly on above Section Plat

If a producing well is abandoned, date of last production 19
Was permission obtained from the Conservation Division or its agents before plugging was commenced? Yes

Name of Conservation Agent who supervised plugging of this well Howard Hess
Producing formation _____ Depth to top _____ Bottom _____ Total Depth of Well 4310 Feet
Show depth and thickness of all water, oil and gas formations.

OIL, GAS OR WATER RECORDS

CASING RECORD

FORMATION	CONTENT	FROM	TO	SIZE	PUT IN	PULLED OUT
Surface pipe		-0-	218	8 5/8"	218	None

Describe in detail the manner in which the well was plugged, indicating where the mud fluid was placed and the method or methods used in introducing it into the hole. If cement or other plugs were used, state the character of same and depth placed, from _____ feet to _____ feet for each plug set.

Filled hole with heavy mud.

#1 plug @ 229' with 25 sks. cement.

#2 plug @ 40' with 8 sks. cement.

#3 plug in rat hole with 2 sks. cement.

RECEIVED
STATE CORPORATION COMMISSION
JUL 7 1969
CONSERVATION DIVISION
Wichita, Kansas


(If additional description is necessary, use BACK of this sheet)
Name of Plugging Contractor Sweetman Drilling, Inc.
Address Box 645, Great Bend, Kansas 67530

STATE OF Kansas COUNTY OF Barton, ss.
T. D. Sweetman (employee of owner) or (owner or operator) of the above-described

well, being first duly sworn on oath, says: That I have knowledge of the facts, statements, and matters herein contained and the log of the above-described well as filed and that the same are true and correct. So help me God.

(Signature) T. D. Sweetman
Box 645, Great Bend, Kansas 67530
(Address)

Subscribed and sworn to before me this 3rd day of July 19 69
Reata L. Boyd
Notary Public.

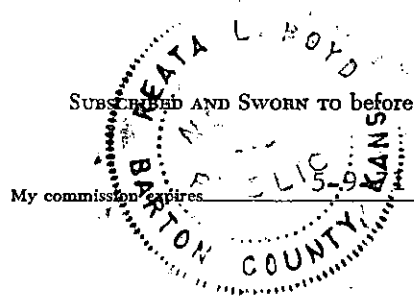

WELL LOG
Plett #1
C SW SW 10-30S-3W
Sumner County, Kansas

FROM	TO	
0	236	Red Bed
236	650	Shale
650	2889	Lime & Shale
2889	3045	Sand
3045	3396	Lime
3396	3813	Lime & Shale
3813	3871	Lime
3871	4190	Lime and chert
4190	4265	Shale and lime
4265	4285	Lime
4285	4310	Sand
4310		Total Depth

RECEIVED
STATE CORPORATION COMMISSION
JUL 7 1969
CONSERVATION DIVISION
Wichita, Kansas

STATE OF KANSAS

COUNTY OF BARTON ss

T. D. Sweetman, President of Sweetman Drilling, Inc., being first duly sworn on oath says: That I have knowledge of the facts, statements and matters herein contained and the log of the above described well as filed and that the same are true and correct.

T. D. Sweetman
T. D. Sweetman

Subscribed and sworn before me this 3rd day of July, 1969.

Leata L. Boyd
Notary Public Barton County

