

STATE OF KANSAS  
STATE CORPORATION COMMISSION


WELL PLUGGING RECORD

Give All Information Completely  
Make Required Affidavit  
Mail or Deliver Report to:  
Conservation Division  
State Corporation Commission  
800 Bittling Building  
Wichita, Kansas

OR  
FORMATION PLUGGING RECORD

Strike out upper line  
when reporting plug-  
ging off formations.

Summer County. Sec. 9 Twp. 30 Rge. (E) 3 (W)  
Location as "NE $\frac{1}{4}$ NW $\frac{1}{4}$ SW $\frac{1}{4}$ " or footage from lines SW $\frac{1}{4}$  SE $\frac{1}{4}$  SW $\frac{1}{4}$   
Lease Owner The Palmer Oil Corporation  
Lease Name Leddy Well No. 1  
Office Address 415 Union National Bank Building, Wichita 2, Kansas  
Character of Well (completed as Oil, Gas or Dry Hole) Dry Hole  
Date well completed 11/17/48 19  
Application for plugging filed 11/17/48 19  
Application for plugging approved 11/17/48 19  
Plugging commenced 11/17/48 19  
Plugging completed 11/17/48 19  
Reason for abandonment of well or producing formation Dry Hole

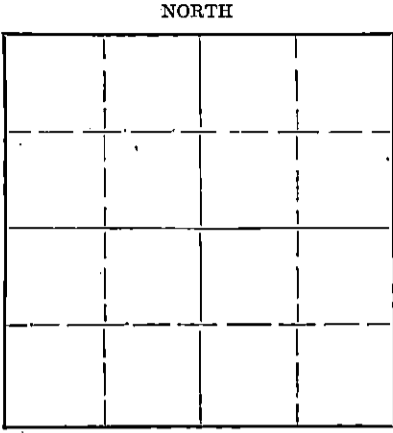

Locate well correctly on above  
Section Plat

If a producing well is abandoned, date of last production 19  
Was permission obtained from the Conservation Division or its agents before plugging was com-  
menced? Yes

Name of Conservation Agent who supervised plugging of this well W. G. Buffington  
Producing formation Depth to top Bottom Total Depth of Well 3911 Feet  
Show depth and thickness of all water, oil and gas formations.

OIL, GAS OR WATER RECORDS

CASING RECORD

Formation	Content	From	To	Size	Put In	Pulled Out
				10-3/4"	127'	None

Describe in detail the manner in which the well was plugged, indicating where the mud fluid was placed and the method or methods used in introducing it into the hole. If cement or other plugs were used, state the character of same and depth placed, from feet to feet for each plug set.

- 3911 - 127 Heavy mud
- 127 - 97 Plug and 15 sacks cement
- 97 - 40 Heavy mud
- 40 - Bottom of cellar - Plug and 10 sacks cement

RECEIVED  
DEC 27 1948  
STATE CORPORATION COMMISSION  
KANSAS

(If additional description is necessary, use BACK of this sheet)  
Correspondence regarding this well should be addressed to The Palmer Oil Corporation  
Address 415 Union National Bank Building, Wichita 2, Kansas

STATE OF KANSAS, COUNTY OF Sedgwick, ss.

A. H. Smith (employee of owner) of the above-described well,  
being first duly sworn on oath, says: That I have knowledge of the facts, statements, and matters herein contained and the log of the above-described well as filed and that the same are true and correct. So help me God.


(Signature) A. H. Smith

Wichita 2, Kansas (Address)

Subscribed and Sworn to before me this 23rd day of December, 1948

Bonnie Duvall  
Notary Public.

My commission expires 3/21/49

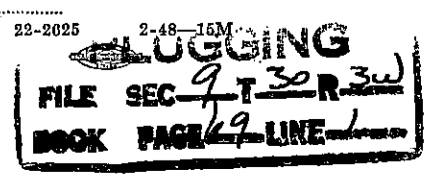

WELL LOG - LEXDY #1

WELL OWNER: The Palmer Oil Corporation  
CONTRACTOR: The Palmer Oil Corporation

Section 9-303-3W  
Location: SW SE SW  
County: Sumner  
Elevation: 1953 D. F.

Commenced: 10/22/48  
Completed: 11/17/48  
RESULTS: Dry Hole

Casing Record  
10-3/4" - 127' cemented 75 sacks

Sand & Clay	0	75
Shale & shells	75	627
Anhydrite	627	700
Shale & shells	700	1040
Salt	1040	1055
Shale & shells	1055	1415
Shale & lime	1415	2420
Shale & shells	2420	2560
Shale & lime	2560	2750
Shale	2750	2810
Shale & lime	2810	2906
Sandy shale	2906	2952
Shaly sand	2952	3060
Shale & lime	3060	3234
Lime	3234	3338
Lime & shale	3338	3372
Lime	3372	3450
Lime & shale	3450	3544
Shale & shells	3544	3564
Shale & lime	3564	3650
Shale & broken lime	3650	3680
Cherty lime & shale	3680	3880
Lime	3880	3911 T.D.

Formation Tops (D.F.)

Taten	2900
Stalnaker	2907
K. C. Lime	3232
Base K. C.	3448
Mississippi Lime	3835
Mississippi Dolomite	3863
Mississippi Chert	3906

Testing Data: Cored 3870 - 75 Recovered 3 3/4' dense dolomite - gray brown  
Cored 3875 - 80 Recovered 4 1/4' dense dolomite - gray brown

Drill Stem Test: 3855 - 80. Tool open 15 minutes - recovered 50' of drilling mud. Some of the mud saved in bucket and after setting about 15 minutes, it showed a very slight rainbow of oil.

This is to certify that the above is a true and correct log, according to the daily drilling reports.

THE PALMER OIL CORPORATION

*A. H. Smith*

STATE OF KANSAS )  
COUNTY OF SEDGWICK ) SS.

Subscribed and sworn to before me, a Notary Public in said county and state this 23rd day of December, 1948.

*Bonnie Duvall*  
Notary Public

My commission expires 3/21/49

