

15-173-00500-0001R

STATE OF KANSAS  
STATE CORPORATION COMMISSION


Form CP-4

WELL PLUGGING RECORD

Give All Information Completely  
Make Required Affidavit  
Mail or Deliver Report to:  
Conservation Division  
State Corporation Commission  
211 No. Broadway  
Wichita, Kansas

Sedgwick County. Sec. 11 Twp. 29 Rge.      (E) 1 (W)  
Location as "NE/CNW%SW%" or footage from lines NW NW NE  
Lease Owner Orville N. Papenhaus  
Lease Name Jordan Well No. 1  
Office Address 211 South First Street, Mulvane, Kansas  
Character of Well (completed as Oil, Gas or Dry Hole) D & A  
Date well completed 5-24-1966  
Application for plugging filed 5-24-1966  
Application for plugging approved 5-24-1966  
Plugging commenced 5-24-1966  
Plugging completed 5-24-1966  
Reason for abandonment of well or producing formation D & A

NORTH

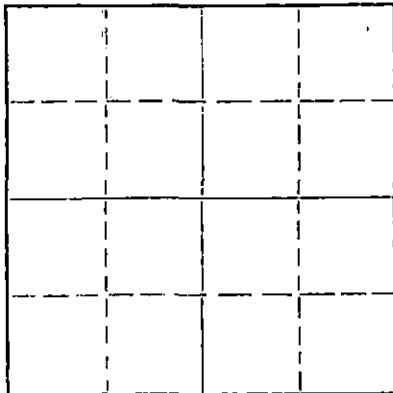

Locate well correctly on above  
Section Plat

If a producing well is abandoned, date of last production      19      
Was permission obtained from the Conservation Division or its agents before plugging was commenced? Yes

Name of Conservation Agent who supervised plugging of this well Paul Turpin  
Producing formation      Depth to top      Bottom      Total Depth of Well 3740 Feet  
Show depth and thickness of all water, oil and gas formations.

OIL, GAS OR WATER RECORDS

CASING RECORD

FORMATION	CONTENT	FROM	TO	SIZE	PUT IN	PULLED OUT

Describe in detail the manner in which the well was plugged, indicating where the mud fluid was placed and the method or methods used in introducing it into the hole. If cement or other plugs were used, state the character of same and depth placed, from      feet to      feet for each plug set.

Mudded hole to 200 ft. with 42 vis. mud. Added 1/2 sack hulls. Set a dry hole plug. Added 20 sacks cement. Mudded hole from this point to 35 ft. added 1/4 sack hulls. Set a plug. Added 8 sacks cement. 4 capped Rat Hole with 2 sacks cement (278 ft. of 8-5/8" surface pipe circulated.)

RECEIVED  
STATE CORPORATION COMMISSION  
MAY 27 1966

(If additional description is necessary, use BACK of this sheet)  
Name of Plugging Contractor WHITE & ELLIS DRILLING, INC.  
Address Box 448, El Dorado, Kansas 67042

STATE OF KANSAS COUNTY OF BUTLER, ss.  
Ernest Sifford, Employed by Contractor of the above-described well, being first duly sworn on oath, says: That I have knowledge of the facts, statements, and matters herein contained and the log of the above-described well as filed and that the same are true and correct. So help me God.

(Signature) Ernest Sifford  
Box 448, El Dorado, Kansas  
(Address)

SUBSCRIBED AND SWORN TO before me this 26th day of May, 19 66

My commission expires September 26, 1968 L. B. Auer Notary Public.


Orville H. Papenhays 11-29-1W 15-173-00500-0001  
 WELL LOG BUREAU—KANSAS GEOLOGICAL SOCIETY  
 503 East Murdock, Wichita, Kansas

Company- GABBERT-JONES DRILLING CO.  
 Farm- Jordon No. 1

SEC. 11 T. 29 R. 1W  
 NW NW NE

Total Depth. 3405  
 Corim. 7-26-55 Comp. 8-4-55  
 Shot or Treated.  
 Contractor. Gabbert-Jones Drilling Co.  
 Issued. 9-17-55

County Sedgwick  
 KANSAS

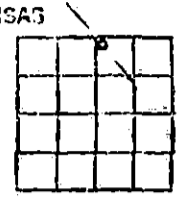

8 5/8" CASING: 278' w/ 200 sx cmt.

Elevation. 1294

Production. Dry

	Figures indicate Bottom of Formations.
surface soil & clay	35
sand	70
shale & lime shells	265
lime	365
lime & shale	384
lime	410
lime & shale	625
lime	785
shale & lime	1280
shale & shells	1570
shale & lime	2470
sand & shale	2565
shale & lime	2825
lime	3212
lime & shale	3300
lime	3405
Total Depth	

TOPS:	
Stalnaker	2470
Kansas City	2760
Mississippi	3296

