

15-173-00394-0000

6


STATE OF KANSAS
STATE CORPORATION COMMISSION
Give All Information Completely
Make Required Affidavit
Mail or Deliver Report to:
Conservation Division
State Corporation Commission
211 No. Broadway
Wichita, Kansas

WELL PLUGGING RECORD

Sedgwick County, Sec. 33 Twp. 29 Rge. 1 (E) 1 (W)

Location as "NE/CNW%SW%" or footage from lines SE SE SW
Lease Owner Shawver Armour, Inc. & Lario Oil & Gas Co.
Lease Name Robertson Well No. 1
Office Address 817 Central Building, Wichita, Kansas
Character of Well (completed as Oil, Gas or Dry Hole) Dry Hole
Date well completed February 19, 19 62
Application for plugging filed February 19 19 62
Application for plugging approved February 19 19 62
Plugging commenced February 19 19 62
Plugging completed February 19, 19 62
Reason for abandonment of well or producing formation Dry Hole

NORTH

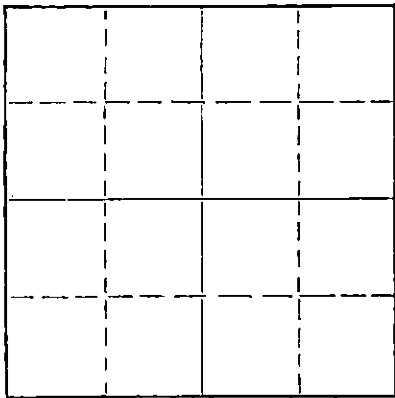

Locate well correctly on above
Section Plat

If a producing well is abandoned, date of last production _____ 19____
Was permission obtained from the Conservation Division or its agents before plugging was commenced? yes

Name of Conservation Agent who supervised plugging of this well Gene Graham
Producing formation _____ Depth to top _____ Bottom _____ Total Depth of Well 3815 Feet
Show depth and thickness of all water, oil and gas formations.

OIL, GAS OR WATER RECORDS

CASING RECORD

FORMATION	CONTENT	FROM	TO	SIZE	PUT IN	PULLED OUT
Surface	water	-0-	307'	8 5/8"	307'	none

Describe in detail the manner in which the well was plugged, indicating where the mud fluid was placed and the method or methods used in introducing it into the hole. If cement or other plugs were used, state the character of same and depth placed, from _____ feet to _____ feet for each plug set.

Heavy mud to 240'
1 Plug 240' Howco plug 1/4 sack hulls & 20 sacks cement
Heavy mud to 30'
2 Plug 30' Howco plug 1/4 sack hulls & 8 sacks cement
Bridge rat @ 5' 2 sacks cement

RECEIVED
STATE CORPORATION COMMISSION
FEB 21 1962
CONSERVATION DIVISION
Wichita, Kansas

(If additional description is necessary, use BACK of this sheet)
Name of Plugging Contractor Shawver Armour, Inc.
Address 817 Central Building, Wichita, Kansas

STATE OF KANSAS, COUNTY OF SEDGWICK, ss.
James M. Armour (owner or operator) of the above-described well, being first duly sworn on oath, says: That I have knowledge of the facts, statements, and matters herein contained and the log of the above-described well as filed and that the same are true and correct. So help me God.

(Signature) James M. Armour
James M. Armour, 817 Central Bldg.
Wichita, Kansas (Address)

SUBSCRIBED AND SWORN TO before me this 26th day of February, 19 62

My commission expires Dec. 29th, 1963
Marjorie Hall Notary Public.



Q

DRILLER'S LOG

FARM NAME: ROBERTSON # 1 LOCATION: SE SE SW Sec 33-29-1W
 Sedgwick County, Kansas
 CONTRACTOR: SHAWVER ARMOUR, INC. ELEVATION: 1254 KB
 OWNER: Shawver Armour, Inc.
 Lario Oil & Gas Company
 COMMENCED: February 8, 1962 COMPLETED: February 19, 1962
 CASING RECORD: 307' 8 5/8" w/230 sacks cement @ 6' sx cc

FORMATION:		TOPS:	
Anhydrite - Shale	345	Stalnaker	2520
Lime - Shale	680	Kansas City	2858
Sandy Lime - Shale	1050	Base Kansas City	3069
Shale - Lime	2520	Mississippian	3437
Stalnaker Sand	2622	Kinderhook	3724
Sand	2682	Simpson	3778
Shale - Lime	2858		
Kansas City Lime	2875		
Lime	3088		
Shale - Lime	3217		
Lime - Shale	3438		
T. Mississippian	3457		
Lime	3666		
Lime - Shale	3728		
Shale	3778		
Simpson Sand	3815		
Rotary Total Depth	3815		

RECEIVED
 STATE COMMISSION

FEB 27 1962

CONSERVATION DIVISION
 Wichita, Kansas

STATE OF KANSAS)
 SEDGWICK COUNTY) ss

I, James M. Armour, do hereby certify that the above log is a true and correct copy of the above captioned well as shown on the daily drilling reports.

SHAWVER ARMOUR, INC.

BY James M. Armour
 James M. Armour

Subscribed and sworn to before me this 20th day of February, 1962.

My commission expires Dec. 29th, 1963.

Marjorie Hall
 Marjorie Hall, Notary Public