

STATE OF KANSAS
STATE CORPORATION COMMISSION
CONSERVATION DIVISION
P. O. BOX 17027
WICHITA, KANSAS 67217

FORM CP-4

WELL PLUGGING RECORD

Summer County. Sec. 19 Twp. 30S Rge. 2W (E) (W)

Location as "NE/CNW/SE/SW" or footage from lines NE SW NE

Lease Owner Chas. Sanders Oil Co., Inc.

Lease Name Corn Well No. 1

Office Address 603 North Edgemoor Wichita, Kansas 67208

Character of Well (completed as Oil, Gas or Dry Hole) Dry Hole

Date well completed 4-17-78 19

Application for plugging filed 4-17-78 19

Application for plugging approved 4-17-78 19


Plugging commenced 4-17-78 19

Plugging completed 4-17-78 19

Reason for abandonment of well or producing formation Dry Hole

If a producing well is abandoned, date of last production 19

Was permission obtained from the Conservation Division or its agents before plugging was commenced? yes

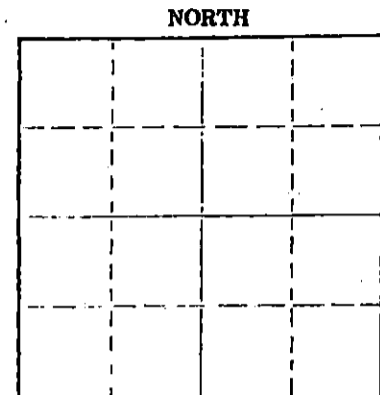

Locate well correctly on above Section Plat

Name of Conservation Agent who supervised plugging of this well Ted E. Dewey

Producing formation Depth to top Bottom Total Depth of Well 3815 Feet

Show depth and thickness of all water, oil and gas formations.

OIL, GAS OR WATER RECORDS

CASING RECORD

Table with 7 columns: FORMATION, CONTENT, FROM, TO, SIZE, PUT IN, PULLED OUT. Row 1: Surface, 8 5/8", 210', none.

Describe in detail the manner in which the well was plugged, indicating where the mud fluid was placed and the method or methods used in introducing it into the hole. If cement or other plugs were used, state the character of same and depth placed, from feet to feet for each plug set.

Plug at 220 feet with 30 sax. of cement. Mud to 40 feet; plug with 10 sax. of cement, 3 sax. of cement in rat hole.

RECEIVED STATE CORPORATION COMMISSION APR 20 1978

Name of Plugging Contractor (If additional description is necessary, use BACK of this sheet) Dunbar Drilling Inc. Address 5252 North Broadway Wichita, Kansas CONSERVATION DIVISION Wichita, Kansas

STATE OF Kansas COUNTY OF Sedgwick ss. W. P. Simmons (employee of owner) or (owner or operator) of the above-described

well, being first duly sworn on oath, says: That I have knowledge of the facts, statements, and matters herein contained and the log of the above-described well as filed and that the same are true and correct. So help me God.

(Signature) W. P. Simmons

SUBSCRIBED AND SWORN TO before me this 19th day of April, 1978 (Address)

My commission expires Jan. 9, 1982

Susan I. McClellan Notary Public.



15-191-20757-0000

DUNBAR DRILLING INC.
5252 NORTH BROADWAY
WICHITA, KANSAS 67219
(316) 832-0501

COMPANY

CHAS. SANDERS OIL CO., INC.

FARM

Corn

WELL

No. 1

LOCATION

NE SW NE Section 19-30S-2W
Sumner County, Kansas

CASING RECORD

8 5/8" @ 210' / 175' sax.
Dry & Abandoned

COMMENCED

4-8-78

COMPLETED

4-17-78

DRILLING CONTRACTOR

DUNBAR DRILLING INC.
5252 NORTH BROADWAY
WICHITA, KANSAS 67219

DRILLERS LOG

FEET

0-7	soil
823	lime & shale
1358	shale
1722	lime & shale
2200	shale & lime
2617	shale & lime
2900	lime & shale
3275	Kansas City Lime
3532	lime & shale
3627	lime
3801	Mississippian Lime
3815	Mississippian lime
3815	r. t. d.

RECEIVED
STATE CORPORATE COMMISSION
APR 26 1978
CONSERVATION DIVISION
Wichita, Kansas