

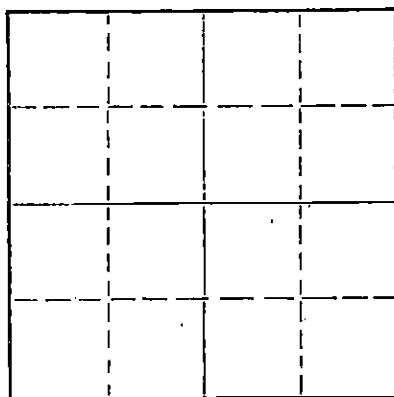
STATE OF KANSAS
STATE CORPORATION COMMISSION

Form CP-4

Give All Information Completely
Make Required Affidavit
Mail or Deliver Report to:
Conservation Division
State Corporation Commission
212 No. Market
Wichita, Kansas

WELL PLUGGING RECORD

NORTH

Locate well correctly on above
Section PlatSEDGWICK County. Sec. 28 Twp. 29S Rge. (E) 1 (W)
SE NE SE

Location as "NE/CNW/SW" or footage from lines. SE NE SE

Lease Owner LEE BANKS

Lease Name TOURBIER Well No. 1

Office Address 725 UNION CENTER BLDG., WICHITA, KANSAS

Character of Well (completed as Oil, Gas or Dry Hole) DRY HOLE

Date well completed 8-31 19 67

Application for plugging filed (LETTER 9-5-67) 8-31 19 67

Application for plugging approved 8-31 19 67

Plugging commenced 8-31 19 67

Plugging completed 8-31 19 67

Reason for abandonment of well or producing formation

If a producing well is abandoned, date of last production 19

Was permission obtained from the Conservation Division or its agents before plugging was commenced? YES

Name of Conservation Agent who supervised plugging of this well HOWARD HESS

Producing formation Depth to top Bottom Total Depth of Well 3740 Feet

Show depth and thickness of all water, oil and gas formations.

OIL, GAS OR WATER RECORDS

CASING RECORD

FORMATION	CONTENT	FROM	TO	SIZE	PUT IN	PULLED OUT
		0	325	8-5/8"	325	NONE

Describe in detail the manner in which the well was plugged, indicating where the mud fluid was placed and the method or methods used in introducing it into the hole. If cement or other plugs were used, state the character of same and depth placed, from feet to feet for each plug set.

FILLED HOLE WITH HEAVY MUD TO 300 FEET. SET FIRST PLUG WITH 1/2 SACK HULLS AND 20

SACKS CEMENT. FILLED HOLE WITH HEAVY MUD TO 40 FEET. SET SECOND PLUG WITH 8 SACKS

CEMENT AND 1/2 SACK HULLS. PLUGGED RAT HOLE WITH 2 SACKS CEMENT. JOB COMPLETE AT

9:00 A.M. AUGUST 31, 1967

RECEIVED
STATE CORPORATION COMMISSION
SEP 7 1967CONSERVATION DIVISION
Wichita, Kansas

(If additional description is necessary, use BACK of this sheet)

Name of Plugging Contractor GABBERT-JONES, INC.

Address 830 SUTTON PLACE, WICHITA, KANSAS

STATE OF KANSAS, COUNTY OF SEDGWICK, ss.
E.E. HALL

(employee of owner) or (owner or operator) of the above-described well, being first duly sworn on oath, says: That I have knowledge of the facts, statements, and matters herein contained and the log of the above-described well as filed and that the same are true and correct. So help me God.

(Signature)

830 SUTTON PLACE, WICHITA, KANSAS

(Address)

SUBSCRIBED AND SWORN TO before me this 5TH day of SEPTEMBER, 1967

My commission expires JUNE 28, 1970

JEAN S. TAYLOR

Notary Public.

GABBERT-JONES, INC.
WICHITA, KANSAS
DRILLERS' WELL LOG

RECEIVED
 STATE CORPORATION COMMISSION

SEP 7 1967

CONSERVATION DIVISION
 Wichita, Kansas

TOURBIER #1
 SE NE SE SECTION 28-29S-1W
 SEDGWICK COUNTY, KANSAS

COMMENCED: AUGUST 21, 1967
 COMPLETED: AUGUST 31, 1967

OPERATOR - LEE BANKS

DEPTH		FORMATION	REMARKS
FROM	TO		
0	40	SAND	
40	180	CLAY & SHALE	
180	325	LIME	RAN 13 JOINTS 8-5/8" CASING, SET @325' W/275 BAGS CEMENT.
325	2480	LIME & SHALE	
2480	2505	SHALE & SAND	
2505	2670	SAND	
2670	2825	SHALE	
2825	2895	LIME & SHALE	
2895	3031	LIME	
3031	3383	LIME & SHALE	
3383	3665	LIME	
3665	3713	SHALE	
3713	3740	SAND	
3740	TD		DRY & ABANDONED.

I, E. E. HALL, CERTIFY THIS IS A CORRECT COPY OF THE DRILLERS' LOG FOR THE WELL DRILLED IN THE SE NE SE SECTION 28-29S-1W, SEDGWICK COUNTY, KANSAS, TO THE BEST OF MY KNOWLEDGE AND BELIEF.

E. E. Hall
 E. E. HALL

STATE OF KANSAS)
) SS
 COUNTY OF SEDGWICK)

BEFORE ME, THE UNDERSIGNED, A NOTARY PUBLIC WITHIN AND FOR SAID COUNTY AND STATE, ON THIS 5TH DAY OF SEPTEMBER, 1967, PERSONALLY APPEARED E. E. HALL, TO ME PERSONALLY KNOWN TO BE THE IDENTICAL PERSON WHO EXECUTED THE WITHIN AND FOREGOING INSTRUMENT AND ACKNOWLEDGED TO ME THAT HE EXECUTED THE SAME AS HIS FREE AND VOLUNTARY ACT AND DEED FOR THE USES AND PURPOSES THEREIN SET FORTH.

IN WITNESS WHEREOF, I HAVE HEREUNTO SET MY HAND AND OFFICIAL SEAL THE DAY AND YEAR LAST ABOVE WRITTEN.

Jean S. Taylor
 JEAN S. TAYLOR, NOTARY PUBLIC

MY COMMISSION EXPIRES JUNE 28, 1970