


15-173-01691-0000

STATE OF KANSAS  
STATE CORPORATION COMMISSION  
Give All Information Completely  
Make Required Affidavit  
Mail or Deliver Report to:  
Conservation Division  
State Corporation Commission  
212 North Market, Insurance Bldg.  
Wichita, Kansas

WELL PLUGGING RECORD

Sedgwick County. Sec. 24 Twp. 29 Rge. 1 (E) W (W)  
Location as "NE/CNW/SW" or footage from lines SW/nw/nw  
Lease Owner Joe Newman  
Lease Name Whitney # 1 Well No. \_\_\_\_\_  
Office Address Skirkmere Apt. Wichita, Kansas  
Character of Well (completed as Oil, Gas or Dry Hole) oil  
Date well completed 7-31-57 19\_\_\_\_  
Application for plugging filed 5-21-59 19\_\_\_\_  
Application for plugging approved 5/22/59 19\_\_\_\_  
Plugging commenced 5-22-59 7:00 am 19\_\_\_\_  
Plugging completed 5-23-59 7:00 pm 19\_\_\_\_  
Reason for abandonment of well or producing formation not a paying producer

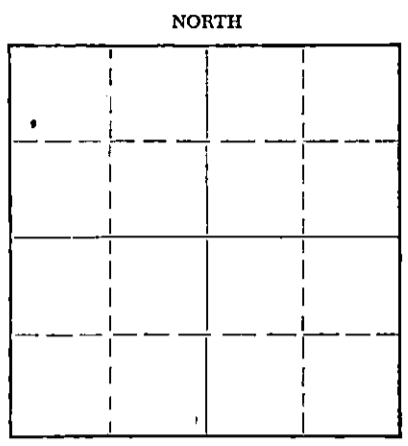

Locate well correctly on above Section Plat

If a producing well is abandoned, date of last production \_\_\_\_\_ 19\_\_\_\_  
Was permission obtained from the Conservation Division or its agents before plugging was commenced? yes

Name of Conservation Agent who supervised plugging of this well Lee Guthrie  
Producing formation Lime Depth to top 3410 Bottom 3416 Total Depth of Well 3822 Feet  
Show depth and thickness of all water, oil and gas formations.

OIL, GAS OR WATER RECORDS

CASING RECORD

FORMATION	CONTENT	FROM	TO	SIZE	PUT IN	PULLED OUT
				8 1/4"	240'	circulated cement
				5 1/2"	3216'	2220'

Describe in detail the manner in which the well was plugged, indicating where the mud fluid was placed and the method or methods used in introducing it into the hole. If cement or other plugs were used, state the character of same and depth placed, from \_\_\_\_\_ feet to \_\_\_\_\_ feet for each plug set.

3374' - 5 sacks cement - dumped wet with bailer,  
255' - 10' rock bridge - 15 sacks cement - dumped dry  
mudded to 35'  
35' - 5' rock bridge - 10 sacks cement - filled to top of surface

NA

RECEIVED  
STATE CORPORATION COMMISSION

JUN 6 1959 6-6-59

CONSERVATION DIVISION  
Wichita, Kansas

(If additional description is necessary, use BACK of this sheet)  
Name of Plugging Contractor Kent Well Servicing Company # 394  
Address Box 667 El Dorado, Kansas

STATE OF Kansas, COUNTY OF Butler, ss.  
C. D. Payne (employee of owner) or (owner or operator) of the above-described well, being first duly sworn on oath, says: That I have knowledge of the facts, statements, and matters herein contained and the log of the above-described well as filed and that the same are true and correct. So help me God.  
(Signature) C. D. Payne  
Box 667, El Dorado, Kansas  
(Address)

SUBSCRIBED AND SWORN TO before me this 31st day of May 1959, 19\_\_\_\_  
Delmar H. Stettin  
Notary Public.

My commission expires 3-14-1960

PLUGGING  
FILE SEC. 24 T. 29 R. 1W  
BOOK PAGE 43 LINE 1