


STATE OF KANSAS
STATE CORPORATION COMMISSION

Give All Information Completely
Make Required Affidavit
Mail or Deliver Report to:
Conservation Division
State Corporation Commission
800 Biting Building
Wichita, Kansas

WELL PLUGGING RECORD

NORTH

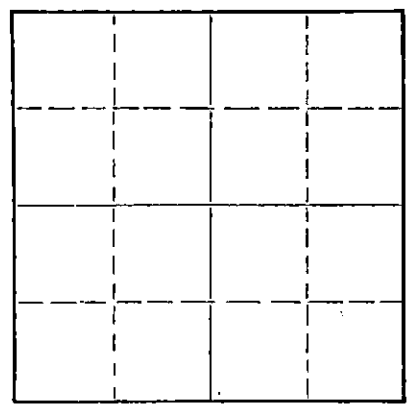

Locate well correctly on above
Section Plat

SEDGWICK County. Sec. 24 Twp. 29S. Rge. 1 (E) (W)
Location as "NE/CNW/SW" or footage from lines NE NE SE
Lease Owners, E. H. Adair & L. E. Phillips, Jr.
Lease Name McKnab Well No. 1
Office Address Adair (1017 E. Second St, Wichita) Phillips (Union Nat'l Bank Bldg.)
Character of Well (completed as Oil, Gas or Dry Hole) DRY HOLE.
Date well completed 10/1 1955
Application for plugging filed 10/18 1955
Application for plugging approved 10/19 1955
Plugging commenced 10/19 1955
Plugging completed 10/21 1955
Reason for abandonment of well or producing formation Dry Hole.

If a producing well is abandoned, date of last production --- 19---
Was permission obtained from the Conservation Division or its agents before plugging was commenced? Yes.

Name of Conservation Agent who supervised plugging of this well S.S. Greider, State Corporation Commission, Wichita, Ks.
Producing formation --- Depth to top --- Bottom --- Total Depth of Well --- Feet
Show depth and thickness of all water, oil and gas formations.

OIL, GAS OR WATER RECORDS

CASING RECORD

FORMATION	CONTENT	FROM	TO	SIZE	PUT IN	PULLED OUT
(Copy of Driller's Log attached hereto)						

Describe in detail the manner in which the well was plugged, indicating where the mud fluid was placed and the method or methods used in introducing it into the hole. If cement or other plugs were used, state the character of same and depth placed, from --- feet to --- feet for each plug set.

Dumped five (5) sacks cement on top of plug at 3350 feet. Mud to 269 feet; 15 feet rock bridge to 254 ft. and 15 sacks cement mud to 50 feet, rock and 5 sacks cement to one foot below ground level. Filled to surface.

(If additional description is necessary, use BACK of this sheet)
Name of Plugging Contractor E. H. ADAIR OIL COMPANY
Address 1017 EAST SECOND STREET, WICHITA 7, KANSAS.

STATE OF KANSAS, COUNTY OF SEDGWICK, ss.
K. W. JOHNSON (employee of owner) or ~~(owner or operator)~~ of the above-described well, being first duly sworn on oath, says: That I have knowledge of the facts, statements, and matters herein contained and the log of the above-described well as filed and that the same are true and correct. So help me God.

(Signature) [Signature]
K. W. JOHNSON
1017 East Second St., Wichita 7, Kansas.
(Address)

SUBSCRIBED AND SWORN to before me this 25th day of October, 19 55,

My commission expires 9/15/57.
[Signature] L. Hill. Notary Public.

PLUGGING
FILE SEC 24 T 29 R 1 W
BOOK PAGE 9 LINE 29

10-27-55

E. H. Adair Oil Company
 1017 East Second St.
 Wichita 7, Kansas.

E. H. Adair and Lee Phillips
 No. 1 McKnab
 NE NE SE
 Sec. 24 - Twp. 29S. R. 1W.
 Sedgwick County, Kansas.

Comm. 9-21-55
 Comp. 10-1-55
 Contractor: Adair Rig #3
 8-5/8 @ 271 ft. w/ 55 sx.
 5 1/2 @ 3360 w/100 sx.

Elev. 1282 K.B.

Figures indicate the bottoms of the Formations

Clay	to 10	Black shale	to 2870
Shale & sand	82	Saturated lime	2877
Shale & shells	264	Lime	2900
Lime	267	Black shale	2902
Lime & shells	340	Lime	2907
Lime	510	Oolitic lime	2915
Lime & shale	650	Lime	2941
Sandy lime	725	Shale	2944
Lime & shells	850	Lime	2965
Shale & shells	1640	Shale	3008
Shale & lime	1920	Lime	3018
Lime	1965	Limey shale	3050
Shale & lime	1990	Lime	3060
Lime	2146	Black shale	3062
Black shale	2151	Lime	3074
Lime	2153	Shale	3081
Shale	2173	Lime	3102
Lime	2175	Limey shale	3121
Shale	2223	Black shale	3123
Lime	2231	Shale	3126
Shale	2415	Lime	3157
Lime	2418	Limey shale	3167
Sand	2457	Lime	3179
Sandy shale	2497	Black shale	3181
Sand	2555	Lime & shale	3200
Shale	2586	Lime	3218
Sandy shale	2700	Shale	3220
Shale	2757	Dark shale	3223
Lime	2772	Shaley lime	3238
Porous lime	2800	Limey colored shale	3250
Lime	2805	Black shale	3253
Dark shale	2807	Lime	3264
Lime	2822	Limey colored shale	3292
Porous lime	2829	Lime	3307
Lime	2850	Limey colored shale	3319
Oolitic lime	2855	Chert	3323
Lime	2868	Lime	3327
		Limey colored shale	3360
		Saturated Chert	3370

DST #1 2867-78, recovered 110 ft.
 muddy salt-water. BHP 1070#

DST #2 3358-70, recovered 40 ft.
 slightly oil cut mud.

PLUGGING
 FILE SEC-24-29-1W
 BOX PAGE 9 LINE 29

RECEIVED
 STATE COMMISSION
 OCT 28 1955

E. H. Adair & Lee Phillips. No. 1 McKnab - Sedgwick County, Kansas.

Geological Tops

Heebner	2146	(-864)
Douglas	2231	(-949)
Lansing	2415	(-1133)
Stalnaker	2418	(1136)
K.C.	2757	(-1475)
Base/K.C.	2965	(-1683)
Miss. Chert	3319	(-2037)

Certified Correct:

Z. W. Johnson
Geologist.

(4)

RECEIVED