


STATE OF KANSAS  
STATE CORPORATION COMMISSION

WELL PLUGGING RECORD

Give All Information Completely  
Make Required Affidavit  
Mail or Deliver Report to:  
Conservation Division  
State Corporation Commission  
800 Bittling Building  
Wichita, Kansas

NORTH

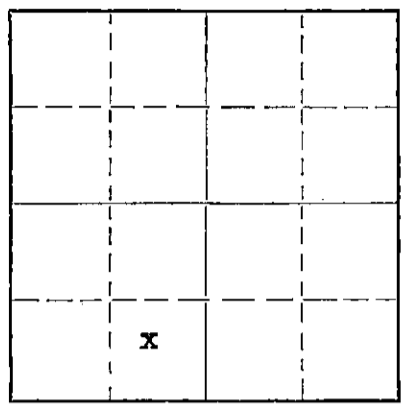

Locate well correctly on above  
Section Plat

Sedgwick County. Sec. 23 Twp. 29 Rge. 1 (E) 1 (W)  
Location as "NE/CNW $\frac{1}{4}$ SW $\frac{1}{4}$ " or footage from lines Gen SE $\frac{1}{4}$  SW $\frac{1}{4}$   
Lease Owner Roy  
Lease Name Roy Well No. 1  
Office Address \_\_\_\_\_  
Character of Well (completed as Oil, Gas or Dry Hole) Dry Hole  
Date well completed Oct. 15, 1949 19  
Application for plugging filed Oct. 15, 1949 19  
Application for plugging approved Oct. 15, 1949 19  
Plugging commenced Oct. 15, 1949 19  
Plugging completed Oct. 15, 1949 19  
Reason for abandonment of well or producing formation Dry  
If a producing well is abandoned, date of last production \_\_\_\_\_ 19  
Was permission obtained from the Conservation Division or its agents before plugging was commenced? Yes

Name of Conservation Agent who supervised plugging of this well \_\_\_\_\_  
Producing formation \_\_\_\_\_ Depth to top \_\_\_\_\_ Bottom \_\_\_\_\_ Total Depth of Well \_\_\_\_\_ Feet  
Show depth and thickness of all water, oil and gas formations.

OIL, GAS OR WATER RECORDS

CASING RECORD

Formation	Content	From	To	Size	Put In	Pulled Out

Describe in detail the manner in which the well was plugged, indicating where the mud fluid was placed and the method or methods used in introducing it into the hole. If cement or other plugs were used, state the character of same and depth placed, from \_\_\_\_\_ feet to \_\_\_\_\_ feet for each plug set.

Plug at 127 feet cemented with 15 sacks of cement filled with mud to 3373 and cement to top with 10 sacks of cement.

(If additional description is necessary, use BACK of this sheet)

Correspondence regarding this well should be addressed to Eckland Drilling Company  
Address 218 Bissantz Building  
Wichita, Kansas

STATE OF Kansas, COUNTY OF Sedgwick, ss.  
P.A. Eckland (employee of owner) or (owner or operator) of the above-described well, being first duly sworn on oath, says: That I have knowledge of the facts, statements, and matters herein contained and the log of the above-described well as filed and that the same are true and correct. So help me God.

(Signature) P.A. Eckland  
(Address) \_\_\_\_\_

SUBSCRIBED AND SWORN to before me this 22 day of October, 19 49  
C. H. Haden  
Notary Public.

My commission expires November 18, 1952

22-5133-s 9-48-10M

PLUGGING  
FILE SEC 23 T 29 R 1 W  
BOOK PAGE 142 LINE 3

15-173-00124-0000

LOCATION: Roy # 1  
Cen SE SW 23-29-1W  
Sedgwick County, Kansas

COMPANY: CHARLES CARLOCK  
CONTRACTOR: ECKLAND DRILLING CO.

Casing: 119'  
123' 8 5/8"

COMMENCED: 10-4-49

COMPLETED: 10-15-49

TOTAL DEPTH: 3385

DRY

119	surface	3370	lime shale
245	blue shale	3375	shale
278	shale shells	3385	lime Miss
405	gyp shale	3385 T.D.	dry
495	lime shale		
535	shale shells		
680	lime shale		
705	sand		
785	lime shale		
945	shale shells		
1245	shale lime break		
1305	lime shale		Kansas City Lime 2799 (-1516)
1495	shale shells		Mississippi Lime 3375 (2092)
1545	broken lime shale		Total Depth 3385
1665	shale shells		(No commercial show)
1830	shale shells		
1870	Topeka Lime		
2010	lime shale		
2135	lime shale		
2250	lime shale		
2285	lime shale		
2300	sand		
2315	lime sandy		
2360	lime shale		
2468	lime shale		
2505	sand		
2630	lime shale		
2665	lime		
2720	shale		
2799	shale		
2812	K.C. Lime		
2829	lime		
2874	lime		
2889	lime chert		
2900	shale lime		
2945	lime		
2995	lime		
3003	lime		
3025	shale lime shells		
3105	shale shells		
3175	lime shale		
3235	lime shale		
3282	lime shale		
3325	shale shells		
3350	shale		
3370	lime shale		

RECEIVED

Cons. & Res. Div.

OCT 25 1949

STATE CORPORATION  
**PLUGGING**  
 FILE SEC. 23-29-1W  
 BOOK PAGE 120 LINE 3